

MARION

P 2034

3-29-78

MISSISSIPPI BOARD OF WATER COMMISSIONERS
416 North State Street
Jackson, Mississippi 39201

WATER WELL DRILLERS LOG

TOM GRIFFITH

PLUMBING & WELL SERVICE, INC.
firm name

Marion
county well located

3/29/78
date well completed

LANDOWNER:

H. T. Terry Polunette

(mailing address)

WELL LOCATION:

sec. 12 T 2 N R 17 E
8 miles SE of Columbia
(distance) (direction) (nearest town)

WELL PURPOSE: Domestic
(home, irrigation, municipal, industrial)

WELL COMPLETION DATA:

- (1) diameter (inches) 2"
- (2) total depth (feet) 210
- (3) static water level (feet) 45 below top of ground.
- (4) casing P (material), 190 (depth)
- n/a (size) If telescope see back.
- (5) screen 20 (length), 190 (depth to top)
- 2" (size), P (material)
- (6) pump 1 (HP), 10 (yield gpm)
- 9kw (type power)
- (7) electric log no (yes or no)
- n/a (organization running log)

(8) how well bottom plugged
backwash

DRILLERS REMARKS:

description of formations encountered

from to

top soil	0	1
Clay	1	15
Sand	15	35
Clay	35	168
Sand	168	210


RECEIVED

APR 27 1978

MISS. BD. OF WATER COM.

If well telescopes please sketch and show depths.

GROUND LEVEL

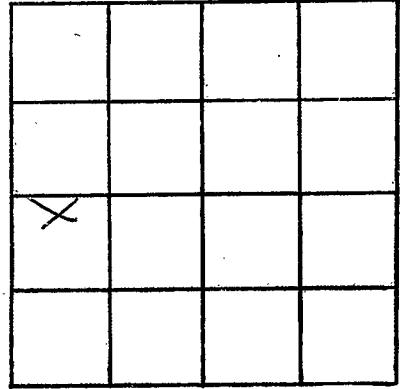

SECTION 12

Please indicate well location X.

ADDITIONAL INFORMATION

If more than one screen,
show locations of each on sketch.