

MARION
P 2025
2-24-78

**MISSISSIPPI  
BOARD OF WATER COMMISSIONERS**  
416 North State Street  
Jackson, Mississippi 39201

**WATER WELL DRILLERS LOG**

2/24 1978 Hollinger Byrd Marion  
 date well completed firm name county well located

LANDOWNER: Wilbur Byrd  
Rt 2 Box 261  
Columbia, MS  
 (mailing address)

description of formations encountered	from	to
	Chalk	0
Sand, pebbles	30	55

WELL LOCATION:  
 sec. 11 T. 3 N. R. 13 E  
2 miles N-E of Pineburg  
 (distance) (direction) (nearest town)

WELL PURPOSE: Home  
 (home, irrigation, municipal, industrial)

WELL COMPLETION DATA:

(1) diameter (inches) 2"

(2) total depth (feet) 55

(3) static water level (feet) 22 below above top of ground.

(4) casing pvc, 55,  
 (material) (depth)  
 (size) if telescope see back.

(5) screen 5, 50  
 (length) (depth to top)  
2, pvc  
 (size) (material)

(6) pump 1/2, 7  
 (HP) (yield gpm)  
elect.  
 (type power)

(7) electric log \_\_\_\_\_  
 (yes or no)

\_\_\_\_\_  
 (organization running log)

(8) how well bottom plugged sand  
SHARK


DRILLERS REMARKS: Very  
good

**RECEIVED**  
 MAY 8 - 1978

MISS. BD. OF WATER COMM.

If well telescopes please sketch and show depths.

GROUND LEVEL

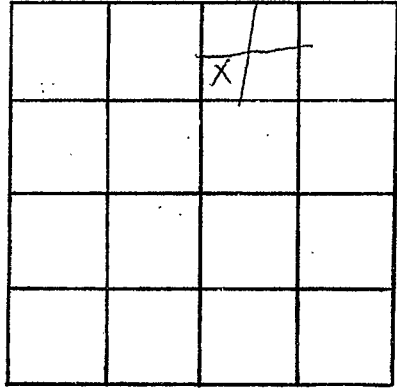

SECTION 11

Please indicate well location X.

ADDITIONAL INFORMATION

A series of horizontal lines for writing additional information.

If more than one screen, show locations of each on sketch.