

MARION  
P 2026  
2/11/78

MISSISSIPPI  
BOARD OF WATER COMMISSIONERS  
416 North State Street  
Jackson, Mississippi 39201

WATER WELL DRILLERS LOG

2-11  
date well completed

1978 - TOM GRIFFITH  
PLUMBING & WELL SERVICE, INC.  
firm name

Marion  
county well located

LANDOWNER:  
Mr. John H. Johnson  
Rt. 2, Columbia  
(mailing address) Miss.

description of formations encountered	from	to
Top soil	0	1
Clay	1	20
Clay	20	85
Sand	85	100

WELL LOCATION:  
sec. 1 T 20 N R 17 E  
S W  
9 miles SE of Columbia  
(distance) (direction) (nearest town)

WELL PURPOSE: Home  
(home, irrigation, municipal, industrial)

- WELL COMPLETION DATA:
- (1) diameter (inches) 2"
  - (2) total depth (feet) 100 ft.
  - (3) static water level (feet) 120 ft. below top of ground.
  - (4) casing plastic, 80 ft. (material) (depth)  
2" (size) if telescope see back.
  - (5) screen 20 ft., 80 ft. (length) (depth to top)  
2" (size) plastic (material)
  - (6) pump 1 HP 5 (HP) (yield gpm)  
Electric (type power)
  - (7) electric log no (yes or no)
- (organization running log)

(8) how well bottom plugged  
B.W. Valve


DRILLERS REMARKS:

RECEIVED  
MAR 21 1978

MISS. BD. OF WATER COMM

If well telescopes please sketch and show depths.

GROUND LEVEL

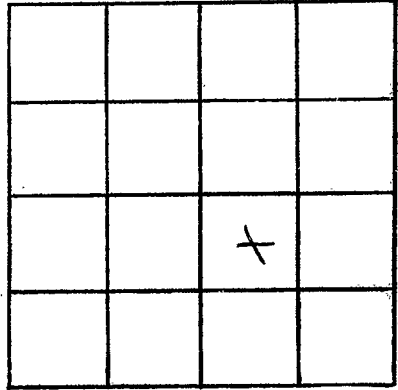

SECTION \_\_\_\_\_

Please indicate well location X.

ADDITIONAL INFORMATION

If more than one screen, show locations of each on sketch.