

MARION  
P 2027  
9-7-77

MISSISSIPPI  
BOARD OF WATER COMMISSIONERS  
416 North State Street  
Jackson, Mississippi 39201

WATER WELL DRILLERS LOG

9/7 1977 Hollinger well Marion  
date well completed firm name county well located

LANDOWNER: Harold Beach  
Rt 2 Box 289 B  
Columbia Miss  
(mailing address)

description of formations encountered	from	to
CLAY SAND	0	140 180

WELL LOCATION:  
sec. 12 T. 2 N. R. 7 E. S. 17 W.  
3 miles N of Pine Bluff  
(distance) (direction) (nearest town)

WELL PURPOSE: Home  
(home, irrigation, municipal, industrial)

WELL COMPLETION DATA:

(1) diameter (inches) 2"  
(2) total depth (feet) 180 ft.  
(3) static water level (feet) 40 below top of ground.  
(4) casing PVC 175' (material) (depth)  
(size) if telescope see back.  
(5) screen 5 175' (length) (depth to top)  
2" PVC (size) (material)  
(6) pump 1 7 (HP) (yield gpm)  
elect. (type power)  
(7) electric log (yes or no)  
(organization running log)


(8) how well bottom plugged sand SHARK

DRILLERS REMARKS: PAR

RECEIVED  
SEP 18 1977

If well telescopes please sketch and show depths.

GROUND LEVEL

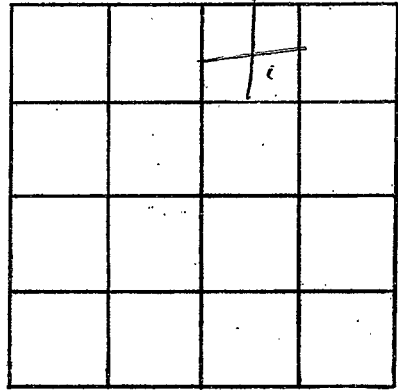

SECTION 12

Please indicate well location X.

ADDITIONAL INFORMATION

If more than one screen,  
show locations of each on sketch.