

Marion
P 2028
6/9/77

MISSISSIPPI
BOARD OF WATER COMMISSIONERS
416 North State Street
13V Jackson, Mississippi 39201

WATER WELL DRILLERS LOG

6/9 1977 Hollinger Plumbing & Well Marion
date well completed firm name county well located

LANDOWNER: <u>William Lister</u>	description of formations encountered	from	to
<u>Rt 2 Box 176 B</u> <u>Columbia Miss</u> (mailing address)			
	<u>Chalk, sand, gravel</u>	<u>0</u>	<u>29</u>
	<u>Chalk</u>	<u>29</u>	<u>190</u>
	<u>sands</u>	<u>190</u>	<u>245</u>

WELL LOCATION:
sec. 12 T. 2 (N) R. 17 E
3 ²⁵ miles N of Pine Bluff
(distance) (direction) (nearest town)

WELL PURPOSE: Home
(home, irrigation, municipal, industrial)

- WELL COMPLETION DATA:
- (1) diameter (inches) 2"
 - (2) total depth (feet) 245
 - (3) static water level (feet) 90 ^{below} _{above} top of ground.
 - (4) casing pvc, 235,
(material) (depth)
10 If telescope see back.
(size)
 - (5) screen 10, 235
(length) (depth to top)
2", pvc
(size) (material)
 - (6) pump 1, 6
(HP) (yield gpm)
elect.
(type power)
 - (7) electric log _____
(yes or no)

(organization running log)

(8) how well bottom plugged sand
SHARK


DRILLERS REMARKS: good well

RECEIVED
JUN 15 1977

MISS. BD. OF WATER COMMISSIONERS

If well telescopes please sketch and show depths.

GROUND LEVEL

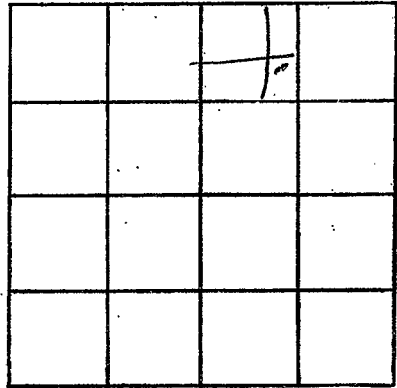

SECTION 12

Please indicate well location X.

ADDITIONAL INFORMATION

If more than one screen,
show locations of each on sketch.