

Marion
 P 2029
 11/75

MISSISSIPPI
 BOARD OF WATER COMMISSIONERS
 416 North State Street
 Jackson, Mississippi 39201

WATER WELL DRILLERS LOG

Nov 1975 E. B. Sherrard Marion
 date well completed firm name county well located

LANDOWNER:
 Shelby Fortenberry
 Columbia, Ms.
 (mailing address)

| description of formations encountered | from | to |
|---------------------------------------|------|-----|
| SANDY CLAY | 0 | 15' |
| SAND + PEAT CL. | 15' | 18' |

WELL LOCATION:
 sec 14 T 2 N R 17 E 13V
 S W
 10 1/2 miles SE of Columbia
 (distance) (direction) (nearest town)

WELL PURPOSE:
 home irrigation, municipal, industrial


- WELL COMPLETION DATA:
- (1) diameter (inches) 2"
 - (2) total depth (feet) 28'
 - (3) static water level (feet) 18' ^{below} above top of ground.
 - (4) casing pl. 23'
 (material) (depth)
 2" if telescope see back.
 (size)
 - (5) screen 5'
 (length) (depth to top)
 2" pl.
 (size) (material)
 - (6) pump 1/2 7
 (HP) (yield gpm)
E
 (type power)
 - (7) electric log (yes or no)
 (organization running log)
 - (8) how well bottom plugged BWV

DRILLERS REMARKS:

RECEIVED
 NOV 5 1975
 MISS. BD. OF WATER COMMISSIONERS

If well telescopes please sketch and show depths.

GROUND LEVEL

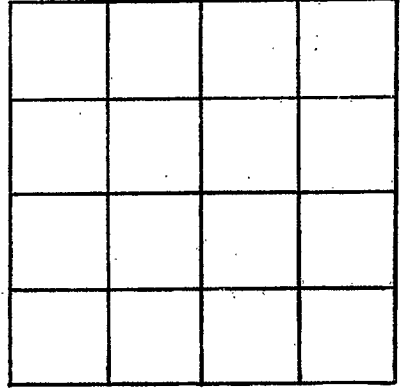

SECTION _____

Please indicate well location X.

ADDITIONAL INFORMATION

If more than one screen,
show locations of each on sketch.