

Marion  
 P 2030  
 11/75

MISSISSIPPI  
 BOARD OF WATER COMMISSIONERS  
 416 North State Street  
 Jackson, Mississippi 39201

WATER WELL DRILLERS LOG

Nov. 25 1975 E. B. Sheppard Marion  
 date well completed firm name county well located

LANDOWNER:  
 Evelyn Fortenberry  
 Columbia, Ms.  
 (mailing address)

| description of formations encountered | from | to  |
|---------------------------------------|------|-----|
| GRAY SANDY CLAY                       | 0    | 18' |
| SAND + GRAVEL                         | 18   | 28' |

WELL LOCATION:  
 sec. 14 T 20 N R 17 E 13V  
 10 1/2 miles SE of Columbia  
 (distance) (direction) (nearest town)

WELL PURPOSE:  
 (home, irrigation, municipal, industrial)

- WELL COMPLETION DATA:
- (1) diameter (inches) 2"
  - (2) total depth (feet) 28'
  - (3) static water level (feet) 20' below top of ground.
  - (4) casing pl. 23' (material) (depth)  
 2" (size) If telescope see back.
  - (5) screen 5' (length) (depth to top)  
 2" (size) pl. (material)
  - (6) pump 1/2 (HP) 8 (yield gpm)  
 E (type power)
  - (7) electric log (yes or no)
  - (organization running log)
  - (8) how well bottom plugged BWV


RECEIVED  
 DEC 5 1975

MISS. BD. OF WATER COMMISSIONERS

DRILLERS REMARKS:

If well telescopes please sketch and show depths.

GROUND LEVEL

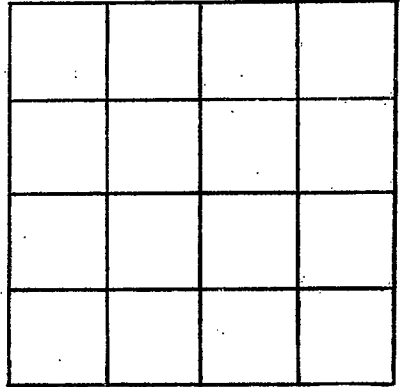

SECTION \_\_\_\_\_

Please indicate well location X.

ADDITIONAL INFORMATION

If more than one screen, show locations of each on sketch.