

MISSISSIPPI DEPARTMENT OF NATURAL RESOURCES

Bureau of Land and Water Resources

Southport Mall

P.O. Box 10631

Jackson, Mississippi 39209

WATER WELL DRILLERS LOG

MARION
P 2033

8-26 1989
date well completed

Louis Batson
firm name

Marion
county well located


LANDOWNER: Albert Lee
Rt. 2 Box 217
Columbia, MS. 39429
(mailing address)

description of formations encountered	from	to
<u>Sand, gravel</u>	<u>1</u>	<u>27</u>
<u>Chalk</u>	<u>27</u>	<u>115</u>
<u>Shale</u>	<u>115</u>	<u>140</u>
<u>Sand, per gravel</u>	<u>140</u>	<u>180</u>

WELL LOCATION:
sec. 10 T. 2 N S R. 17 E
10 miles S of Columbia
(distance) (direction) (nearest town)

WELL PURPOSE: home
(home, irrigation, municipal, industrial)

- WELL COMPLETION DATA:
- (1) diameter (inches) 2"
 - (2) total depth (feet) 180 ft.
 - (3) static water level (feet) 170 below above top of ground.
 - (4) casing PVC 180
(material) (depth)
2" if telescope see back.
(size)
 - (5) screen 10 170
(length) (depth to top)
2 PVC
(size) (material)
 - (6) pump _____ (HP) _____ (yield gpm)
(type power)
 - (7) electric log _____ (yes or no)
(organization running log)
 - (8) how well bottom plugged _____

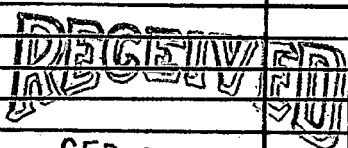

Department of Natural Resources
Bureau of Land & Water Resources

DRILLERS REMARKS:

