

MARION

MISSISSIPPI DEPARTMENT OF NATURAL RESOURCES
Bureau of Land and Water Resources
Southport Mall
P.O. Box 10631
Jackson, Mississippi 39209
WATER WELL DRILLERS LOG

7-5-86
date well completed

Tom Griffith Well Service
firm name

county well located

LANDOWNER: FRED IDOM

description of formations encountered

from

to

SAND

1

60

(mailing address)

WELL LOCATION:

sec. — T — N R — E
S W
miles of Columbia
(distance) (direction) (nearest town)

WELL PURPOSE: DOMESTIC WELL
(home, irrigation, municipal, industrial)

WELL COMPLETION DATA:

(1) diameter (inches) 2"
(2) total depth (feet) 60'
(3) static water level (feet) below above
top of ground.

(4) casing PVC 50'
(material) (depth)
If telescope see back.
(size)

(5) screen 10' 50'
(length) (depth to top)
2" PVC
(size) (material)

(6) pump (HP) (yield gpm)
(type power)

(7) electric log No
(yes or no)
NA
(organization running log)

(8) how well bottom plugged
BWV

DRILLERS REMARKS:


RECEIVED

NOV 7 1986

Department of Natural Resources
Bureau of Land & Water Resources

If well telescopes please sketch and show depths.

GROUND LEVEL

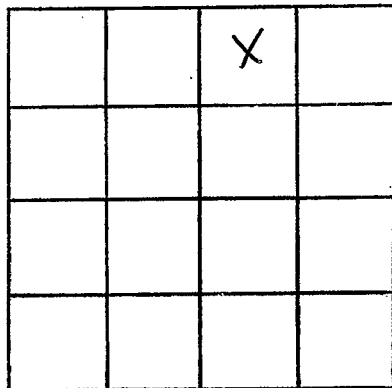

SECTION _____

Please indicate well location X.

ADDITIONAL INFORMATION

If more than one screen,
show locations of each on sketch.