

MARION
~~207~~
 10-27-76

MISSISSIPPI
 BOARD OF WATER COMMISSIONERS
 416 North State Street
 Jackson, Mississippi 39201

WATER WELL DRILLERS LOG

Marion
Waterwell

10-27 1976 *Samy Poole* firm name
 date well completed county well located

LANDOWNER: *Samy Poole*
Box 224
Sandy Hook, Miss.
~~*Orange, Miss.*~~
 (mailing address)

description of formations encountered	from	to
<i>Red clay</i>	<i>0</i>	<i>30</i>
<i>Sand gravel</i>	<i>30</i>	<i>67</i>

WELL LOCATION:
 sec. *18 T-1 N* R. *14 E*
3 miles *W* of *Sandy Hook*
 (distance) (direction) (nearest town)

WELL PURPOSE: *Home*
 (home, irrigation, municipal, industrial)

- WELL COMPLETION DATA:
- (1) diameter (inches) *2"*
 - (2) total depth (feet) *67*
 - (3) static water level (feet) *40* ^{below} above top of ground.
 - (4) casing *pvc* *67*
 (material) (depth)
 _____ if telescope see back.
 (size)
 - (5) screen *5 ft.* *2"*
 (length) (depth to top)
pvc *pvc*
 (size) (material)
 - (6) pump *1* *8*
 (HP) (yield gpm)
elect
 (type power)
 - (7) electric log *NO*
 (yes or no)
- _____
 (organization running log)
- (8) how well bottom plugged *sand*
5 Hook


DRILLERS REMARKS: *good well*

RECEIVED

NOV 18 1976

If well telescopes please sketch and show depths.

GROUND LEVEL

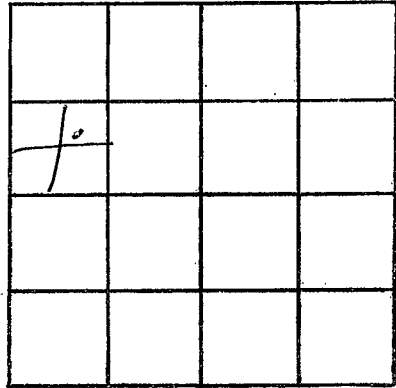

SECTION 18

Please indicate well location X.

ADDITIONAL INFORMATION

If more than one screen,
show locations of each on sketch.