

Marion
 Q 10
 8-68

MISSISSIPPI
 BOARD OF WATER COMMISSIONERS
 416 North State Street
 Jackson, Mississippi 39201

CODE

WATER WELL DRILLERS LOG

8-15 1968 *Reagan & Fair* *Marion*
 date well completed firm name county well located

LANDOWNER: *Josh Pittman*
Forwards, Miss

description of formations encountered

from to

(mailing address)

Clay 0 100
sand & clay 100 110
Coarse sand 112 144

WELL LOCATION:

sec. 34 T. 1 (N) R. 14 (E)
14 miles SE of Kokomo
 (distance) (direction) (nearest town)

WELL PURPOSE: *home*
 (home) irrigation, municipal, industrial

WELL COMPLETION DATA:

(1) diameter (inches) 4"
 (2) total depth (feet) 144'
 (3) static water level (feet) 32' (below/above top of ground)

(4) casing plast. 136'
 (material) (depth)
 (size) if telescope see back.


(5) screen 8' 136'
 (length) (depth to top)
.008 plast.
 (size) (material)

(6) pump 3/4 (HP) (yield gpm)
plast.
 (type power)

(7) electric log no (yes or no)
 (organization running log)


(8) how well bottom plugged Back
wash valve

DRILLERS REMARKS:

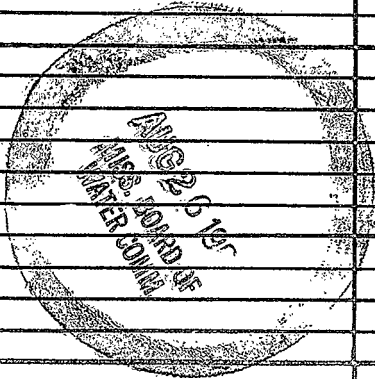

If well telescopes please sketch and show depths.

GROUND LEVEL

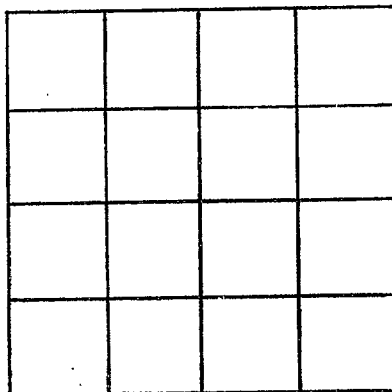

SECTION _____

Please indicate well location X.

ADDITIONAL INFORMATION

If more than one screen, show locations of each on sketch.