

MARION
Q 11
1-69

MISSISSIPPI
BOARD OF WATER COMMISSIONERS
416 North State Street
Jackson, Mississippi 39201

CODED

WATER WELL DRILLERS LOG

DEC. 1969 E. B. SHERRARD MARION
date well completed firm name county well located

LANDOWNER:	description of formations encountered	from	to
DAVID SPEIGHTS SANDY Hook, Miss (mailing address)			
WELL LOCATION: sec 31 T 1 N R 14 E 15 miles S of COLUMBIA (distance) (direction) (nearest town)	WATER SAND & GRAVEL	100	144
WELL PURPOSE: (home) irrigation, municipal, industrial			
WELL COMPLETION DATA:			
(1) diameter (inches) 2"			
(2) total depth (feet) 144			
(3) static water level (feet) 78 below top of ground			
(4) casing (Elastic) 144 (material) (depth)			
2" (size) if telescope see back.			
(5) screen 3' (length) (depth to top)			
2 1/2" (size) S.S. (material)			
(6) pump 1 (HP) 208 (yield gpm)			
(type power)			
(7) electric log (yes or no)			
(organization running log)			
(8) how well bottom plugged BN			

CODED


FEB 5 1970

MISS. BD. OF
WATER COMML

DRILLERS REMARKS:

If well telescopes please sketch and show depths.

GROUND LEVEL

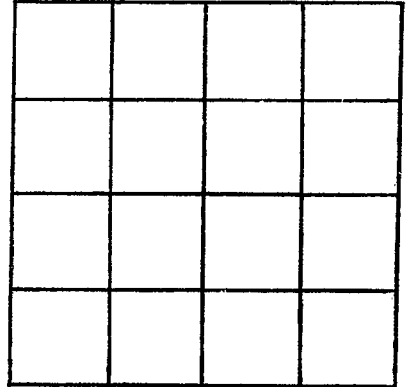

SECTION _____

Please indicate well location X.

ADDITIONAL INFORMATION

If more than one screen, show locations of each on sketch.