

Rtn 1/5/70

" 2/24/70

Jafford 3/18/70
JRU

INDEXED

MISSISSIPPI
BOARD OF WATER COMMISSIONERS
416 North State Street
Jackson, Mississippi 39201

WATER WELL DRILLERS LOG

Marion
Q 12
9-9-69

Sept 9 1969 Harold Woodward MARION
date well completed firm name county well located
Water Well Drilling

LANDOWNER: Johannes Reinlin
Pt. 2 Sandy Hook

description of formations encountered	from	to
Sand	8	18
f. gravel & sand	18	29
med. gravel	30	49

(mailing address)

WELL LOCATION: 14E
sec 34 T 1 N
2 miles S-E of Sandy Hook
(distance) (direction) (nearest town)

WELL PURPOSE: Home
(home, irrigation, municipal, industrial)

WELL COMPLETION DATA:

- (1) diameter (inches) 4" plastic
- (2) total depth (feet) 48 ft
- (3) static water level (feet) 8 below top of ground.
- (4) casing PVC pipe 40 ft (material) (depth)
4" (size) if telescope see back.
- (5) screen 8 (length) 10 (depth to top)
4" (size) plastic (material)
- (6) pump (HP) (yield gpm)
1/2 AC (type power)
- (7) electric log U (yes or no)
Self (organization running log)
- (8) how well bottom plugged 2" sand
Shank Beach Wash Hook

set in Very coarse sand & gravel

INDEXED

set at 47 ft.


JAN 5 1970

MISS. DEPT. OF WATER CONTROL

DRILLERS REMARKS: set in Very good formation

If well telescopes please sketch and show depths.

GROUND LEVEL

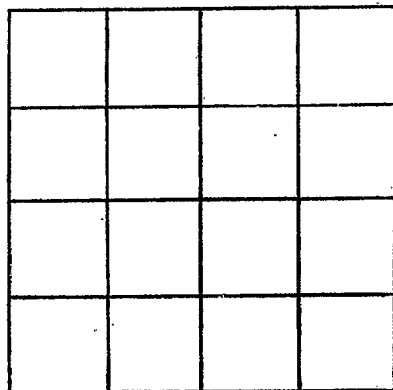

SECTION _____

Please indicate well location X.

ADDITIONAL INFORMATION

If more than one screen, show locations of each on sketch.