

Marion
Q 13
10-21-69

MISSISSIPPI
BOARD OF WATER COMMISSIONERS
416 North State Street
Jackson, Mississippi 39201

CODED

WATER WELL DRILLERS LOG

10/21 1969 Dean Griner Marion
date well completed firm name county well located

LANDOWNER:

description of formations encountered

from to

Bill Warren
Route Sandyhook, Miss.
(mailing address)

Top soil 0-1
clay 1-10
sand 10-40
water sand 40-68

WELL LOCATION:

sec. 17 T 1 N R 14 E
2 miles N of Sandyhook
(distance) (direction) (nearest town)

WELL PURPOSE:

Home Use
(home, irrigation, municipal, industrial)

WELL COMPLETION DATA:

- (1) diameter (inches) 2"
- (2) total depth (feet) 68'
- (3) static water level (feet) _____ below above top of ground.
- (4) casing Plastic, 62' (material) (depth)
- _____ if telescope see back. (size)
- (5) screen 4' 64' (length) (depth to top)
2" S.S. Griner (size) (material)
- (6) pump 1/2 HP Jacuzzie jet pump (HP) (yield gpm) (type power)
- (7) electric log No (yes or no)

CODED

MAR 18 1970

MISS. BD. OF WATER COMM.


(organization running log)

(8) how well bottom plugged _____

DRILLERS REMARKS:

If well telescopes please sketch and show depths.

GROUND LEVEL

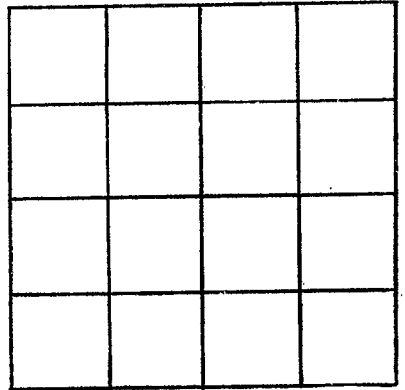

SECTION _____

Please indicate well location X.

ADDITIONAL INFORMATION

If more than one screen, show locations of each on sketch.