

MARION
Q14
11-10-70

MISSISSIPPI
BOARD OF WATER COMMISSIONERS
416 North State Street
Jackson, Mississippi 39201

CODED

WATER WELL DRILLERS LOG

11-10 1970 *Fitzgerald* firm name *Marion* county well located

LANDOWNER:
Charles Herrin
~~3300~~ *R.R. 2 South Hawk*
(mailing address)

description of formations encountered	from	to
<i>Red Clay</i>	<i>0</i>	<i>20</i>
<i>Red Sand</i>	<i>20</i>	<i>80</i>
<i>Coarse Sand</i>	<i>80</i>	<i>90</i>

WELL LOCATION:
sec. *18* T. *1* N. S. R. *14* E.
3 miles *WNW* of *South Hawk*
(distance) (direction) (nearest town)

WELL PURPOSE: *Home*
(home, irrigation, municipal, industrial)

- WELL COMPLETION DATA:
- (1) diameter (inches) *4*
 - (2) total depth (feet) *90*
 - (3) static water level (feet) *40* below above top of ground.
 - (4) casing *plastic*, *84*,
(material) (depth)
4 if telescope see back.
(size)
 - (5) screen *6*, *84*
(length) (depth to top)
 - 4*, *plastic*
(size) (material)
 - (6) pump *1*, *7*
(HP) (yield gpm)
Elva
(type power)
 - (7) electric log *no*
(yes or/no)
(organization running log)
 - (8) how well bottom plugged *completely*

CODED


NOV 16 1970

DRILLERS REMARKS:

MISS. BD. OF
WATER COM.

If well telescopes please sketch and show depths.

GROUND LEVEL

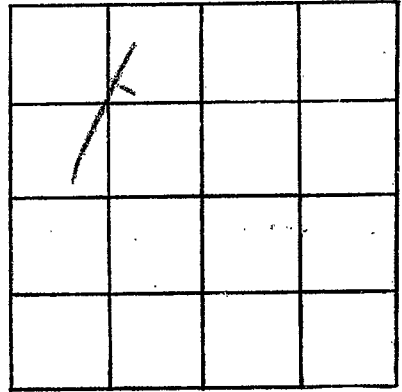

SECTION 18

Please indicate well location X.

ADDITIONAL INFORMATION

If more than one screen,
show locations of each on sketch.