

MARION
 316
 9/13

MISSISSIPPI
 BOARD OF WATER COMMISSIONERS
 416 North State Street
 Jackson, Mississippi 39201

CODED

WATER WELL DRILLERS LOG

Sept. 29 1973 E.P. Sheppard Marion
 date well completed firm name county well located

LANDOWNER: C.A. Hammond
 description of formations encountered: SANDY CLAY from 0 to 20'
 SAND & GR. 20 45'
 Pt. 1 - Sandy Hook, Ms (mailing address)

WELL LOCATION:
 sec. 6 T 1 N R 14 E
 S W
 4 miles NW Sandy Hook
 (distance) (direction) (nearest town)

WELL PURPOSE:
 (home, irrigation, municipal, industrial)

- WELL COMPLETION DATA:
- (1) diameter (inches) 2 1/2"
 - (2) total depth (feet) 45'
 - (3) static water level (feet) 22' below top of ground.
 - (4) casing pl. 40' (material) (depth)
 2" if telescope see back. (size)
 - (5) screen 5' (length) (depth to top)
 2" pl. (size) (material)
 - (6) pump 1/2 (HP) 8 (yield gpm)
 E (type power)
 - (7) electric log (yes or no)
 - (organization running log)
 - (8) how well bottom plugged B.W.V.


CODED

DRILLERS REMARKS:

FEB
 MISS. DEPT. OF WATER CONTROL

If well telescopes please sketch and show depths.

GROUND LEVEL

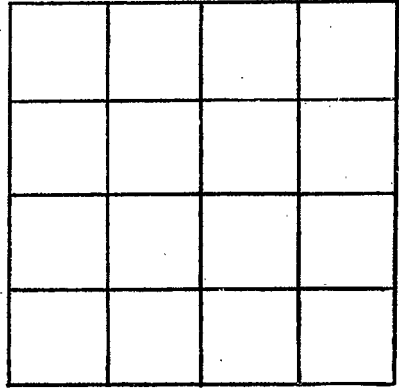

SECTION _____

Please indicate well location X.

ADDITIONAL INFORMATION

If more than one screen, show locations of each on sketch.