

MARION  
 Q 17  
 12-12-73

MISSISSIPPI  
 BOARD OF WATER COMMISSIONERS  
 416 North State Street  
 Jackson, Mississippi 39201

CODED

WATER WELL DRILLERS LOG

GRINER - GINN

Marion

12-12-73  
 date well completed

firm name

county well located

LANDOWNER:  
 Ralph Craft  
 Rt. 2 Sandy Hook,  
 (mailing address) Miss.

description of formations encountered	from	to
Top Soil	0	2
Clay	2	18
Gravel	18	43
Chalk	43	84
Gravel	84	115
Chalk	115	135
Sand	135	185

WELL LOCATION:  
 sec. 17 T. 1 N. R. 14 E.  
 1.3 miles S.W. of Folsom  
 (distance) (direction) (nearest town)

WELL PURPOSE: Bowl  
 (home, irrigation, municipal, industrial)

CODED

- WELL COMPLETION DATA:
- (1) diameter (inches) 4"
  - (2) total depth (feet) 185
  - (3) static water level (feet) 130 below top of ground.
  - (4) casing plastic, 175,  
 (material) (depth)  
4"  
 (size) if telescope see back.
  - (5) screen 10', 175  
 (length) (depth to top)  
4", plastic  
 (size) (material)
  - (6) pump 3/4, 8  
 (HP) (yield gpm)  
elec.  
 (type power)
  - (7) electric log NO  
 (yes or no)  
NO  
 (organization running log)
  - (8) how well bottom plugged  
B.W. Valve


DRILLERS REMARKS:

RECEIVED  
 MAY 22 1974

MISS. DEPARTMENT OF AGRICULTURE

If well telescopes please sketch and show depths.

GROUND LEVEL

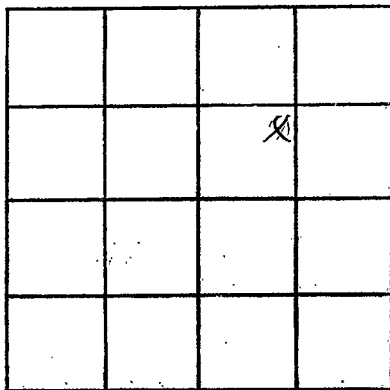

SECTION 17

Please indicate well location X.

ADDITIONAL INFORMATION

If more than one screen, show locations of each on sketch.