

Maion  
 618  
 8174

MISSISSIPPI  
 BOARD OF WATER COMMISSIONERS  
 416 North State Street  
 Jackson, Mississippi 39201

CODED

WATER WELL DRILLERS LOG

August 1974 E.B. Sherard Maion  
 date well completed firm name county well located

LANDOWNER:  
 Frank Smith  
 Sandy Hook, Ms.  
 (mailing address)

description of fomations encountered  
 SAND & GRAVEL @ 60'

WELL LOCATION:  
 sec. 6 T. 4 N. R. 14 E.  
 S  
 12 miles S of Columbia  
 (distance) (direction) (nearest town)

WELL PURPOSE:  
 home irrigation, municipal, industrial


- WELL COMPLETION DATA:
- (1) diameter (inches) 2"
  - (2) total depth (feet) 60'
  - (3) static water level (feet) 18' <sup>below</sup> <sub>above</sub> top of ground.
  - (4) casing pl. 55'  
 (material) (depth)  
 2" if telescope see back.  
 (size)
  - (5) screen 5'  
 (length) (depth to top)  
 2" pl.  
 (size) (material)
  - (6) pump 1/3 7  
 (HP) (yield gpm)  
E  
 (type power)
  - (7) electric log  (yes or no)
  - (organization running log)
  - (8) how well bottom plugged BWV

DRILLERS REMARKS:

RECEIVED  
 MAY 8 1975  
 MISS. BD. OF WATER COMMISSIONERS

If well telescopes please  
sketch and show depths.

GROUND LEVEL.

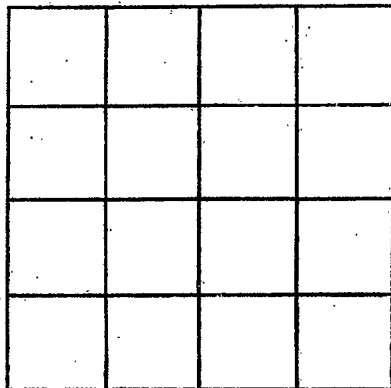

SECTION \_\_\_\_\_

Please indicate well location X.

ADDITIONAL INFORMATION

If more than one screen,  
show locations of each on sketch.