

Marion
 Q 21
 6-2-79

MISSISSIPPI
 BOARD OF WATER COMMISSIONERS
 416 North State Street
 Jackson, Mississippi 39201

WATER WELL DRILLERS LOG

CODED

6-2 1979 Griner Drilling Marion
 date well completed firm name county well located

LANDOWNER:
 Sonat Exploration Co.
 P.O. Box 1513
 Houston, Tx. 77001
 (mailing address)

description of formations encountered	from	to
Sand & gravel	0	84
clay, sand, gravel	84	105
gravel, clay, sand	105	126
sand	126	147
sand & gravel	147	189
sand & gravel	189	210
sand & clay	210	230

WELL LOCATION: 1500' N + 2640' E
 sec. 27 T. 1 N R. 14 E of
 Sandy Hook, MSW/COR.
 (distance) (direction) (nearest town)

WELL PURPOSE: oil field supply
 (home, irrigation, municipal, industrial)

- WELL COMPLETION DATA:
- diameter (inches) 4"
 - total depth (feet) 230'
 - static water level (feet) 40' (below top of ground)
 - casing Steel, 210' (material) (depth)
 4" (size) If telescope see back.
 - screen 42' (length) 168' (depth to top)
 4" (size) perforated (material)
 - pump 90 (HP) (yield gpm)
 AC (type power)
 - electric log (yes or no)
 (organization running log)

(8) how well bottom plugged orange peel

DRILLERS REMARKS:

CODED


Miss. Board of Water Comm.

JUN 28 1979

RECEIVED

If well telescopes please sketch and show depths.

GROUND LEVEL

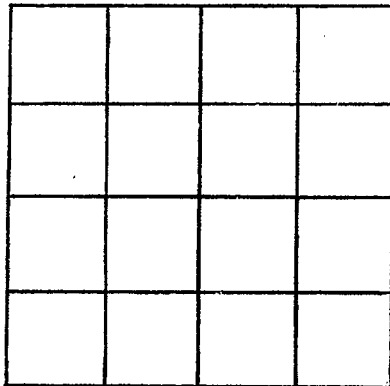

SECTION _____

Please indicate well location X.

ADDITIONAL INFORMATION

If more than one screen, show locations of each on sketch.