

MARION

Q-22

1-9-80

MISSISSIPPI BOARD OF WATER COMMISSIONERS 416 North State Street Jackson, Mississippi 39201

CODED

WATER WELL DRILLERS LOG

1-9-80 Griner Drilling Marion

date well completed

firm name

county well located

LANDOWNER:

EXXON Oil Company P.O. Box 53225 New Orleans, La (mailing address)

description of formations encountered

from

to

Sand + gravel 0 182 clay + sand 182 537 sand 537 644

WELL LOCATION: 1500' N + 1500' E

No. 1 Sand Dec. 13 T-1 N R-18 of Hook Gas South of Columbia Springs, La. Unit (distance in miles, direction, nearest town)

WELL PURPOSE: WATER SUPPLY (home, irrigation, municipal, industrial)

WELL COMPLETION DATA:

- (1) diameter (inches) 8"
(2) total depth (feet) 644'
(3) static water level (feet) 10' below top of ground
(4) casing Steel, 630' (material) (depth) 4" (size) If telescope see back.
(5) screen 42' 588' (length) (depth to top) 4" perforated (size) (material)
(6) pump (HP) 80 (yield gpm) AC (type power)
(7) electric log (yes or no)

(8) how well bottom plugged peel orange


DRILLERS REMARKS:

DEPT. OF NATURAL RESOURCES BUREAU OF LAND & WATER RESOURCES

JAN 24 1980 RECEIVED

If well telescopes please sketch and show depths.

GROUND LEVEL

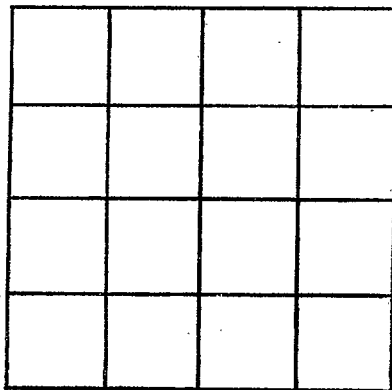

SECTION _____

Please indicate well location X.

ADDITIONAL INFORMATION

If more than one screen,
show locations of each on sketch.