

MARION
 Q-23
 5-8-80

MISSISSIPPI
 BOARD OF WATER COMMISSIONERS CODED
 416 North State Street
 Jackson, Mississippi 39201

WATER WELL DRILLERS LOG

5-8-80 date well completed
 Griner Drilling firm name
 Marion county well located

LANDOWNER:
 SONAT Exploration
 P.O. Box 1513
 Houston, TX 77001
 (mailing address)

description of formations encountered	from	to
clay	0	10
gravel + sand	10	210
clay + sand	210	231
gravel + sand	231	273
clay + sand	273	290

WELL LOCATION: 214415 + 1500W
 sec 33 T 10N R 4E of
 F.E. Forbes Sandy Hook
 (distance) (direction) (nearest town)

WELL PURPOSE:
 (home, irrigation, municipal, industrial)

WELL COMPLETION DATA:

(1) diameter (inches) 4"

(2) total depth (feet) 290'

(3) static water level (feet) 40' below top of ground

(4) casing Steel 273'
 (material) (depth)
 4" (size) if telescope see back.

(5) screen 42' 231'
 (length) (depth to top)
 4" perforated
 (size) (material)

(6) pump 70
 (HP) (yield gpm)
 AC (type power)

(7) electric log (yes or no)

(organization running log)

(8) how well bottom plugged orange
 peel

DRILLERS REMARKS:


DEPT. OF NATURAL RESOURCES
 BUREAU OF LAND & WATER RESOURCES

MAY 20 1980

RECEIVED

If well telescopes please sketch and show depths.

GROUND LEVEL

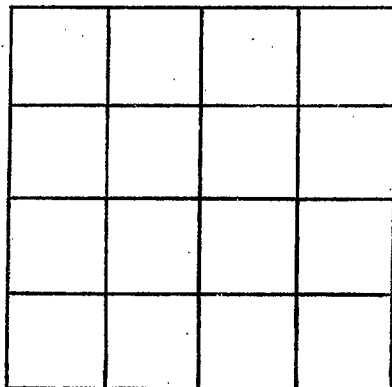

SECTION _____

Please indicate well location X.

ADDITIONAL INFORMATION

If more than one screen, show locations of each on sketch.