

MARION

Q-24
7/22/80

MISSISSIPPI  
BOARD OF WATER COMMISSIONERS  
416 North State Street  
Jackson, Mississippi 39201

CODED

WATER WELL DRILLERS LOG

*Spring Drilling Service, Inc.*  
firm name: *Marion*  
county well located

date well completed

firm name

county well located

LANDOWNER:  
*Exxon Oil Company*  
*P.O. Box 53225*  
*New Orleans, La*  
(mailing address)

description of formations encountered	from	to
<i>gravel</i>	<i>0</i>	<i>147</i>
<i>chalk</i>	<i>147</i>	<i>420</i>
<i>streaked rock</i>	<i>420</i>	<i>441</i>
<i>chalk sand</i>	<i>441</i>	<i>483</i>
<i>chalk</i>	<i>483</i>	<i>567</i>

WELL LOCATION: *2400' N + 3050' E*

*no. 16 L N R 14 of 21*  
*hook with*  
*yard*  
distance: \_\_\_\_\_ miles (direction) of \_\_\_\_\_ (nearest town)

WELL PURPOSE: *oil field*  
(home, irrigation, municipal, industrial)

WELL COMPLETION DATA:

① *4" water*  
inches: *4"*  
total depth (feet): *567'*  
(3) static water level (feet) *Flow* above top of ground: *Well*  
(4) casing *steel* (material), *483'* (depth)  
*4"* (size) if telescope see back.  
(5) screen *42'* (length), *441'* (depth to top)  
*4" perforated* (size) (material)  
(6) pump *—* (HP), *80* (yield gpm)  
*AC* (type power)  
(7) electric log *—* (yes or no)  
(organization running log)

CODED

DEPT. OF NATURAL RESOURCES  
BUREAU OF LAND & WATER RESOURCES

(8) how well bottom plugged *orange*  
*peel*


AUG 6 1980

DRILLERS REMARKS:

RECEIVED

If well telescopes please sketch and show depths.

GROUND LEVEL

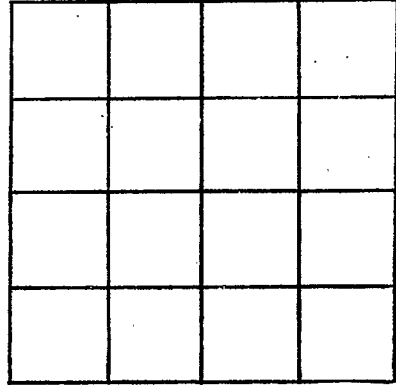

SECTION \_\_\_\_\_

Please indicate well location X.

ADDITIONAL INFORMATION

If more than one screen, show locations of each on sketch.