

MARION

MISSISSIPPI  
BOARD OF WATER COMMISSIONERS  
416 North State Street  
Jackson, Mississippi 39201

CODED

Q-25
8/5/80

WATER WELL DRILLERS LOG

*Grines Drilling Service, Inc.*

*Marion*

date well completed

firm name

county well located

LANDOWNER:  
*Sonat Exploration*  
*P.O. Box 1513*  
*Houston, Texas 77001*  
 (mailing address)

description of formations encountered	depth	
	from	to
<i>gravel</i>	<i>0</i>	<i>21</i>
<i>chalk</i>	<i>21</i>	<i>84</i>
<i>sand-gravel</i>	<i>84</i>	<i>273</i>

WELL LOCATION: *1700' N E 1804' W*  
*no 2* *28-1 N - R 14 E* of *Sandy Hook*  
*J.W. Hook* *SE 1/4*  
 (distance) (direction) (nearest town)

WELL PURPOSE: *at field supply*  
 (home, irrigation, municipal, industrial)

CODED

WELL COMPLETION DATA:

- (1) diameter (inches) 4"
- (2) total depth (feet) 273'
- (3) static water level (feet) 10' <sup>below</sup> <sub>above</sub> top of ground.
- (4) casing steel, 273' (material) (depth)  
4" (size) if telescope see back.
- (5) screen 42', 231' (length) (depth to top)  
4", perforated (size) (material)
- (6) pump \_\_\_\_\_ (HP) 80 (yield gpm)  
ac (type power)
- (7) electric log \_\_\_\_\_ (yes or no)

(organization running log)

(8) how well bottom plugged *Orange Peel*

DRILLERS REMARKS:


DEPT. OF NATURAL RESOURCES  
BUREAU OF LAND & WATER RESOURCES

AUG 27 1980

RECEIVED

If well telescopes please sketch and show depths.

GROUND LEVEL

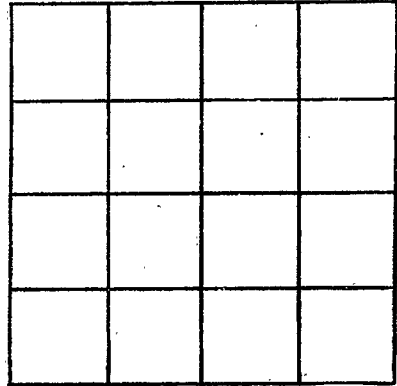

SECTION \_\_\_\_\_

Please indicate well location X.

ADDITIONAL INFORMATION

If more than one screen, show locations of each on sketch.