

MARION

MISSISSIPPI
BOARD OF WATER COMMISSIONERS
416 North State Street
Jackson, Mississippi 39201

CODED

Q-26
11-7-80

WATER WELL DRILLERS LOG

Griner Drilling
Service, Inc

Marion

11-7-80
date well completed

Griner Drilling
firm name

Marion
county well located

LANDOWNER:

Sonat Exploration

P.O. Box 1513
Houston, Texas 77001
(mailing address)

description of formations
encountered

from

to

sand + gravel 6 252
streaked 252 315

WELL LOCATION:

2038'S + 2435'W

sec. 29 T. 1 N R. 14 E of
Sandy Hook

(distance) (direction) (nearest town)

WELL PURPOSE: oil field
(home, irrigation, municipal, industrial)

WELL COMPLETION DATA:

- (1) diameter (inches) 4"
- (2) total depth (feet) 315'
- (3) static water level (feet) 25' ^{below} _{above} top of ground.
- (4) casing steel, 252'
(material) (depth)
4" If telescope see back.
(size)
- (5) screen 42' 210'
(length) (depth to top)
4" perforated
(size) (material)
- (6) pump 100
(HP) (yield gpm)
ac
(type power)
- (7) electric log
(yes or no)

(organization running log)


(8) how well bottom plugged range

DRILLERS REMARKS: peel

RECEIVED
DEC 4 1980
DEPT. OF NATURAL RESOURCES
BUREAU OF LAND & WATER RESOURCES

If well telescopes please sketch and show depths.

GROUND LEVEL

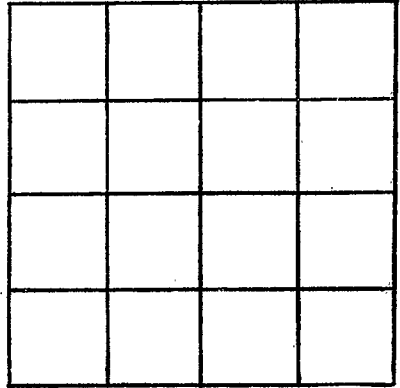

SECTION _____

Please indicate well location X.

ADDITIONAL INFORMATION

If more than one screen, show locations of each on sketch.