

MISSISSIPPI DEPARTMENT OF NATURAL RESOURCES

Bureau of Land and Water Resources

Southport Mall

P.O. Box 10631

Jackson, Mississippi 39209

WATER WELL DRILLERS LOG

Griner Drilling Service, Inc.

CODED

Marion

MARION
Q 21
2-19-81
2-19-81

date well completed

firm name

county well located

LANDOWNER:

Sonat Exploration
P.O. Box 1513
Houston, Texas 77001
(mailing address)

description of formations encountered

from to

sand + p-gravel 0 109
Clay 109 115
sand - p-gravel 115 252

WELL LOCATION: 1500'S + 250'E

No. 32 T 10 R 14 of West Sandy Hook Field
Forbes (distance) (direction) (nearest town)

WELL PURPOSE: oil field supply
(home, irrigation, municipal, industrial)

WELL COMPLETION DATA:

- (1) diameter (inches) 4"
- (2) total depth (feet) 252'
- (3) static water level (feet) 0 below above top of ground.
- (4) casing steel 252' (material) (depth)
4" (size) if telescope see back.
- (5) screen 42' 210' (length) (depth to top)
4" perforated (size) (material)
- (6) pump 100 (HP) (yield gpm)
AC (type power)
- (7) electric log (yes or no)
- (organization running log)
- (8) how well bottom plugged orange peel

CODED

DEPT. OF NATURAL RESOURCES
BUREAU OF LAND & WATER RESOURCES


MAR 31 1981

RECEIVED

DRILLERS REMARKS:

If well telescopes please sketch and show depths.

GROUND LEVEL

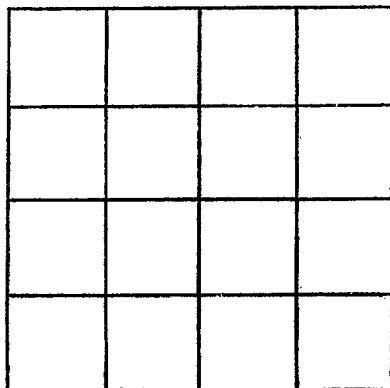

SECTION _____

Please indicate well location X.

ADDITIONAL INFORMATION

If more than one screen, show locations of each on sketch.