

MISSISSIPPI DEPARTMENT OF NATURAL RESOURCES

Bureau of Land and Water Resources

Southport Mall

P.O. Box 10631

Jackson, Mississippi 39209

WATER WELL DRILLERS LOG

Griner Drilling Service, Inc.

Marion

Marion  
Q 28  
3-30-81

CODED

3-30-81  
date well completed

firm name

county well located

LANDOWNER:  
Sonat Exploration  
P.O. Box 1513  
Houston, Texas  
(mailing address)

description of formations encountered from to  
streaked, mostly SAND 0 140


WELL LOCATION: 1500'S & 1500'E  
No. 1 sec. 34 T-10 N R-14E of Rankin West Sandy Hook Field  
(distance) miles (direction) of (nearest town)

SAND, gravel 140 189

WELL PURPOSE: oil field supply  
(home, irrigation, municipal supply)

WELL COMPLETION DATA:

- (1) diameter (inches) 4"
- (2) total depth (feet) 189'
- (3) static water level (feet) 15' below top of ground.
- (4) casing steel 189' (material) (depth)  
4" (size) if telescope see back.
- (5) screen 42' 147' (length) (depth to top)  
4" perforated (size) (material)
- (6) pump — 85 (HP) (yield gpm)  
AC (type power)
- (7) electric log — (yes or no)

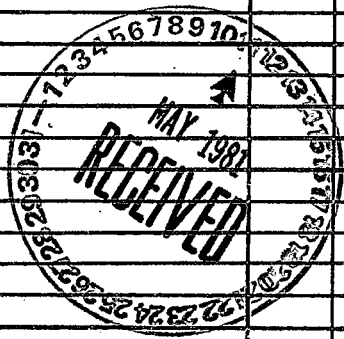


(organization running log)  
(8) how well bottom plugged peel orange

DRILLERS REMARKS:

If well telescopes please sketch and show depths.

GROUND LEVEL

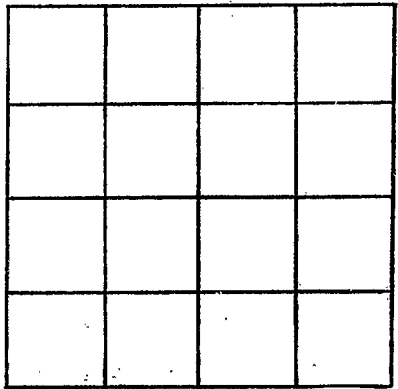

SECTION \_\_\_\_\_

Please indicate well location X.

ADDITIONAL INFORMATION

If more than one screen,  
show locations of each on sketch.