

MISSISSIPPI DEPARTMENT OF NATURAL RESOURCES

Bureau of Land and Water Resources

Southport Mall

P.O. Box 10631

CODED

Jackson, Mississippi 39209

WATER WELL DRILLERS LOG

MARION
Q 29
9-29-81

9-29-81 Griner Drilling Service, Inc Marion
 date well completed firm name county well located

LANDOWNER:
Champlin Petroleum
P.O. Box 411
Jackson, MS 39205
 (mailing address)

description of formations encountered	from	to
sand, gravel	0	147
chalk	147	336

WELL LOCATION: 1600'S + 1850'E
 sec. 9 T 1 N R 14 E N 1/4 NW 1/4
No. 1 For Penberry Sandy Hook
 (distance) (direction) (nearest town)

streaked	336	462
chalk	462	483
streaked	483	546

WELL PURPOSE: oil field
 (home, irrigation, municipal, industrial)

18' sand, 3' chalk	546	567
--------------------	-----	-----

- WELL COMPLETION DATA:
- (1) diameter (inches) 4"
 - (2) total depth (feet) 672'
 - (3) static water level (feet) flow below top of ground. well above
 - (4) casing steel 672'
 (material) (depth)
4" if telescope see back.
 (size)
 - (5) screen 42' 630'
 (length) (depth to top)
4" perforated
 (size) (material)
 - (6) pump — 100
 (HP) (yield gpm)
AC
 (type power)
 - (7) electric log —
 (yes or no)
 (organization running log)

streaked	567	609
sand	609	672

CODED.

(8) how well bottom plugged orange
peel

DRILLERS REMARKS: _____


DEPT. OF NATURAL RESOURCES
 BUREAU OF LAND & WATER RESOURCES

OCT - 6 1981

RECEIVED

If well telescopes please sketch and show depths.

GROUND LEVEL

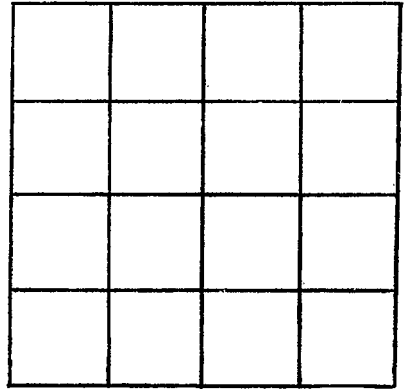

SECTION _____

Please indicate well location X.

ADDITIONAL INFORMATION

If more than one screen, show locations of each on sketch.