

MISSISSIPPI DEPARTMENT OF NATURAL RESOURCES

Bureau of Land and Water Resources

Southport Mall

P.O. Box 10631

Jackson, Mississippi 39209

WATER WELL DRILLERS LOG

Griner Drilling Service, Inc.

Marion

MARION
Q 31
8-2-82

8-2-82 date well completed

Griner Drilling Service, Inc. firm name

Marion county well located

LANDOWNER:	description of formations encountered	from	to
Tesoro Petroleum Corp. 1726 1/2 10th Street Laurel, Ms. 39440 (mailing address)			
WELL LOCATION: Fr. SW 1/4 Cor Sec. 26 101 sec. 26 T. 10 N. R. 11 E. S. 31 Sandy Gas Hook 35 West Sandy Hook Unit	clay	0	30
	sand, gravel streaks of clay	30	200
	clay - few breaks of sand	200	798
WELL PURPOSE: oil field supply (home, irrigation, municipal, industrial)			
WELL COMPLETION DATA:			
(1) diameter (inches) 3"			
(2) total depth (feet) 798'			
(3) static water level (feet) 40' below top of ground.			
(4) casing Steel 210' (material) (depth) 3" (size) if telescope see back.			
(5) screen 42' 168' (length) (depth to top) 3" perforated (size) (material)			
(6) pump (HP) 75 (yield gpm) AC (type power)			
(7) electric log (yes or no)			
(organization running log)			
(8) how well bottom plugged orange peel			
DRILLERS REMARKS:			


DEPT. OF NATURAL RESOURCES
BUREAU OF LAND & WATER RESOURCES

AUG - 4 1982

RECEIVED

If well telescopes please sketch and show depths.

GROUND LEVEL

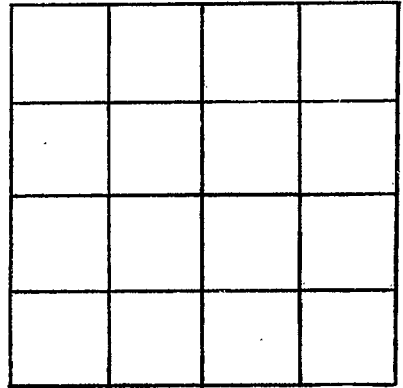

SECTION _____

Please indicate well location X.

ADDITIONAL INFORMATION

If more than one screen,
show locations of each on sketch.