

MISSISSIPPI DEPARTMENT OF NATURAL RESOURCES

Bureau of Land and Water Resources

Southport Mall

P.O. Box 10631

Jackson, Mississippi 39209

WATER WELL DRILLERS LOG

CODED

MARION  
Q 32  
4/22/83

Griner Drilling Service, Inc.

Marion

4-22-83  
date well completed

Griner Drilling Service, Inc.  
firm name

Marion  
county well located

LANDOWNER:

EXXON Company U.S.A  
P.O. Box 53037  
New Orleans La 70505  
(mailing address)

description of formations encountered

from

to

clay	0	20
sand, gravel	20	100
clay	100	149
sand, gravel	149	240
streaked clay, sand	240	300

WELL LOCATION:

1500' N + 1580' W  
sec. 20 T. 10 N R. 14 E SEC 20

Sandy Hook Field  
39 (direction) (nearest town)

WELL PURPOSE: oil field supply  
(home, irrigation, municipal, industrial)

WELL COMPLETION DATA:

- (1) diameter (inches) 4"
- (2) total depth (feet) 300'
- (3) static water level (feet) 10' (below above top of ground)
- (4) casing steel 231' (material) (depth)  
4" (size) if telescope see back.
- (5) screen 42' (length) 189' (depth to top)  
4" (size) perforated (material)
- (6) pump — (HP) 85-90 (yield gpm)  
AC (type power)
- (7) electric log — (yes or no)  
— (organization running log)

CODED

Drilled two 4" water wells on location information the same on each well

(8) how well bottom plugged Orange Peel

DRILLERS REMARKS:


DEPT. OF NATURAL RESOURCES  
BUREAU OF LAND & WATER RESOURCES

MAY 16 1983

RECEIVED

If well telescopes please sketch and show depths.

GROUND LEVEL

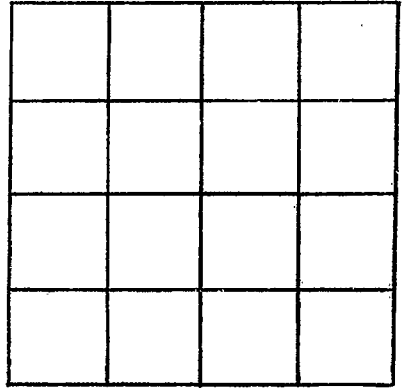

SECTION \_\_\_\_\_

Please indicate well location X.

ADDITIONAL INFORMATION

If more than one screen,  
show locations of each on sketch.