

MISSISSIPPI DEPARTMENT OF NATURAL RESOURCES

Bureau of Land and Water Resources

Southport Mall

P.O. Box 10631

Jackson, Mississippi 39209

CODED

WATER WELL DRILLERS LOG

Griner Drilling Service, Inc.

Marion

MARION
Q33
2-20-84

2-20-84
date well completed

Griner Drilling Service, Inc.
firm name

Marion
county well located

LANDOWNER:	description of formations encountered	from	to
SONAT Exploration P.O. Box 1513 Houston, Tx. 77001 (mailing address)			
WELL LOCATION: 1503'S + 2126' E NO. 3 sec. 28 T. 1 (N) R. 14 (E) 11th cov Forbes West Sand Hook Field (distance) (direction) (nearest town)	CLAY	95	147
WELL PURPOSE: oil field supply (home, irrigation, municipal, industrial)	SAND, peb gravel	147	210
WELL COMPLETION DATA:			
(1) diameter (inches) 4"			
(2) total depth (feet) 210'			
(3) static water level (feet) 10' below top of ground.			
(4) casing steel 210' (material) (depth) 4" (size) if telescope see back.			
(5) screen 42' 168' (length) (depth to top) 4" perforated (size) (material)			
(6) pump 90 (HP) (yield gpm) AC (type power)			
(7) electric log (yes or no)			
(organization running log)			
(8) how well bottom plugged Orange peel			
DRILLERS REMARKS:			

CODED


DEPT. OF NATURAL RESOURCES
BUREAU OF LAND & WATER RESOURCES

FEB 24 1984

RECEIVED

If well telescopes please sketch and show depths.

GROUND LEVEL

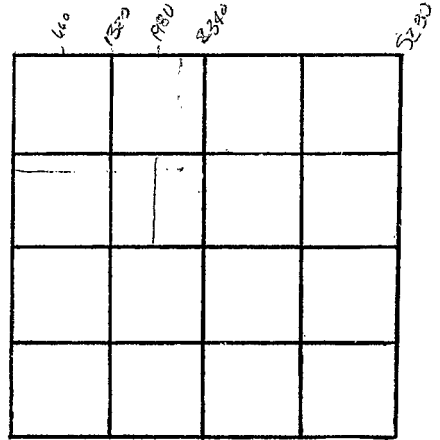

SECTION _____

Please indicate well location X.

ADDITIONAL INFORMATION

If more than one screen, show locations of each on sketch.