

MISSISSIPPI DEPARTMENT OF NATURAL RESOURCES

Bureau of Land and Water Resources

Southport Mall

P.O. Box 10631

Jackson, Mississippi 39209

WATER WELL DRILLERS LOG

CODED

Marion
Q 34
4/13/84

Griner Drilling Service, Inc.

Marion

4-13-84 date well completed



Griner Drilling Service, Inc. firm name

Marion county well located

LANDOWNER:	description of formations encountered	from	to
Exeter Drilling 144 Elk Place Suite 1502 New Orleans, La 70002 <small>(mailing address)</small>	sand, gravel CODED	0	130
WELL LOCATION: 1500'N + 2000'W sec. 33 T. 1 N. R. 19 E. S4/01 No. 1 Boone West Sandy Hook Field <small>(distance) miles (direction) (nearest town)</small>			
WELL PURPOSE: oilfield supply <small>(home, irrigation, municipal, industrial)</small>			
WELL COMPLETION DATA:			
(1) diameter (inches) 3"			
(2) total depth (feet) 130'			
(3) static water level (feet) 10' below top of ground.			
(4) casing steel, 130' (material), (depth) 3" (size) if telescope see back.			
(5) screen 42' (length), 88' (depth to top) 3" (size), perforated (material)			
(6) pump 90 (HP), (yield gpm) ac (type power)			
(7) electric log (yes or no) (organization running log)			
(8) how well bottom plugged Orange peel			
DRILLERS REMARKS:	RESOURCES WATER RESOURCES MAY - 7 1984 RECEIVED		

If well telescopes please sketch and show depths.

GROUND LEVEL

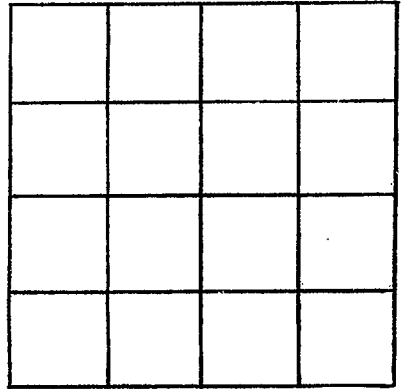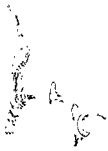

SECTION _____

Please indicate well location X.

ADDITIONAL INFORMATION

If more than one screen,
show locations of each on sketch.