

MISSISSIPPI DEPARTMENT OF NATURAL RESOURCES

Bureau of Land and Water Resources

Southport Mall

P.O. Box 10631

Jackson, Mississippi 39209

WATER WELL DRILLERS LOG

CODED

Marion
Q 35
4/26/84

Griner Drilling Service, Inc.

Marion

4-26-84
date well completed

Griner Drilling Service, Inc.
firm name

Marion
county well located

LANDOWNER:

Bass Petroleum Enterprises

Two Lakeway Center

Suite 1900

3850 N. Causeway

Metairie, La. 70002

WELL LOCATION:

No. 1 sec 9 T 1 N R 1156 W

Orrin (distance) Sandy Hook (nearest town)

Field

WELL PURPOSE: oilfield supply

(home, irrigation, municipal, industrial)

WELL COMPLETION DATA:

- (1) diameter (inches) 3"
- (2) total depth (feet) 399'
- (3) static water level (feet) 10' below top of ground

(4) casing Steel 168' (material) (depth)

3" (size) if telescope see back.

(5) screen 42' 126" (length) (depth to top)

3" perforated (size) (material)

(6) pump 75 (HP) (yield gpm)

AC (type power)

(7) electric log (yes or no)

(organization running log)

(8) how well bottom plugged Orange Deer

description of formations encountered

from

to

clay

0 10

sand, pea gravel

10 165

clay, streaked fine sand

165 399

DEPT. OF NATURAL RESOURCES
BUREAU OF LAND & WATER RESOURCES


MAY - 7 1984

RECEIVED

DRILLERS REMARKS:

If well telescopes please sketch and show depths.

GROUND LEVEL

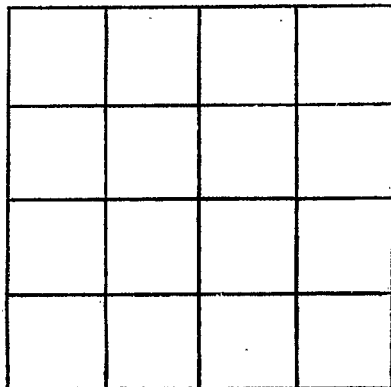

SECTION _____

Please indicate well location X.

ADDITIONAL INFORMATION

If more than one screen, show locations of each on sketch.