

MISSISSIPPI DEPARTMENT OF NATURAL RESOURCES

Bureau of Land and Water Resources

Southport Mall

P.O. Box 10631

Jackson, Mississippi 39209

WATER WELL DRILLERS LOG

CODED

Q36 Q
MARION
12-31-84

12-31-84 Griner Drilling Service, Inc. Marion

date well completed

firm name

county well located


LANDOWNER:	description of formations encountered	from	to
Exeter Drilling 144 Elk Place Suite 1502 New Orleans, La. 70112	clay	0	10
WELL LOCATION: 1875' N 1500' E sec. 22 10 N R. 140 W SW/4 NO. 5 HART W. Sandy Hook Field (distance) (direction) (nearest town)	sand, pea gravel	10	178
WELL PURPOSE: <u>oilfield supply</u> (home, irrigation, municipal, industrial)	clay	178	189
WELL COMPLETION DATA:			
(1) diameter (inches) <u>3"</u>			
(2) total depth (feet) <u>189'</u>			
(3) static water level (feet) <u>10'</u> <u>below</u> above top of ground.			
(4) casing <u>steel</u> <u>168'</u> (material) (depth)			
<u>3"</u> if telescope see back. (size)			
(5) screen <u>42'</u> <u>126"</u> (length) (depth to top)			
<u>3"</u> <u>perforated</u> (size) (material)			
(6) pump <u>-</u> <u>75-80</u> (HP) (yield gpm)			
<u>AC</u> (type power)			
(7) electric log <u>-</u> (yes or (no))			
(organization running log)			
(8) how well bottom plugged <u>Orange peel</u>			
DRILLERS REMARKS:			

CODED

Run 7-8-85

If well telescopes please
sketch and show depths.

GROUND LEVEL

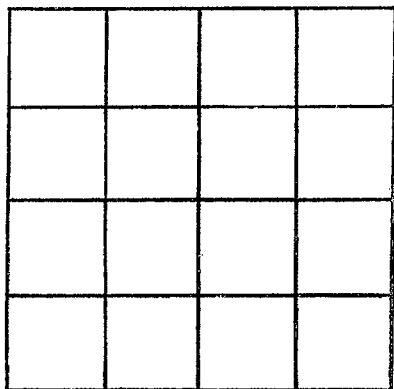

SECTION _____

Please indicate well location X.

ADDITIONAL INFORMATION

If more than one screen,
show locations of each on sketch.