

MISSISSIPPI DEPARTMENT OF NATURAL RESOURCES

Bureau of Land and Water Resources

Southport Mall

P.O. Box 10631

Jackson, Mississippi 39209

WATER WELL DRILLERS LOG

CODED

MARION
Q 37

6-28 1985
date well completed

Hollinsix
firm name

Marion
county well located

LANDOWNER: Everett Jones

Rt 1

Sandy Hook
(mailing address)

description of formations encountered

from

to

Red clay, gravel	0	100
Coarse sand	100	120
Coarse sand, gravel	120	200
Chalk	200	240
Coarse pea gravel	240	270

WELL LOCATION:

sec. 28 T-10 N R-14 E W

Rt 1 miles Sandy Hook
(distance) (direction) (nearest town)

WELL PURPOSE:

(home, irrigation, municipal, industrial)

WELL COMPLETION DATA:

- (1) diameter (inches) 4"
- (2) total depth (feet) 270
- (3) static water level (feet) 105 below above top of ground.
- (4) casing PVC 250
(material) (depth)

_____ If telescope see back.
(size)

- (5) screen 20 250
(length) (depth to top)

4 PVC
(size) (material)

- (6) pump 5 75
(HP) (yield gpm)

elect
(type power)

- (7) electric log _____
(yes or no)

_____ (organization running log)

- (8) how well bottom plugged SAND SHARK

DRILLERS REMARKS: Very good well


RECEIVED

AUG 15 1985

Department of Natural Resources
Bureau of Land & Water Resources

If well telescopes please sketch and show depths.

GROUND LEVEL

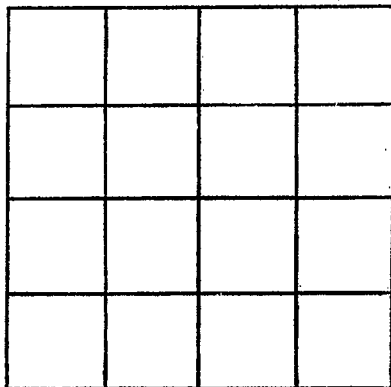

SECTION _____

Please indicate well location X.

ADDITIONAL INFORMATION

If more than one screen,
show locations of each on sketch.