

MISSISSIPPI DEPARTMENT OF NATURAL RESOURCES

Bureau of Land and Water Resources

Southport Mall

P.O. Box 10631

Jackson, Mississippi 39209

WATER WELL DRILLERS LOG

MARION
Q 38

CODED

Griner Drilling Service, Inc.

MARION

11-15-85
date well completed

Griner Drilling Service, Inc.
firm name

MARION
county well located

LANDOWNER:	description of formations encountered	from	to
<u>Tesoro Petroleum Corp</u> <u>P.O. Box 2909</u> <u>Laurel, Ms. 39442</u> (mailing address)			
<u>WELL LOCATION: 1500'S & 1050'E</u> sec. <u>27-T-1(N)</u> R. <u>14(E)</u> of <u>No. 6 Hart W. Sandy Hook Field</u> (distance) (direction) (nearest town)	<u>CLAY</u>	<u>40</u>	<u>90</u>
<u>WELL PURPOSE: oilfield supply</u> (home, irrigation, municipal, industrial)	<u>SAND, GRAVEL,</u> <u>CLAY</u>	<u>90</u>	<u>210</u>
WELL COMPLETION DATA:			
(1) diameter (inches) <u>3"</u>			
(2) total depth (feet) <u>210'</u>			
(3) static water level (feet) <u>35'</u> ^{below} above top of ground.			
(4) casing <u>steel, 210'</u> (material) (depth) <u>3"</u> (size) if telescope see back.			
(5) screen <u>42', 168'</u> (length) (depth to top) <u>3" perforated</u> (size) (material)			
(6) pump <u>—</u> <u>75</u> (HP) (yield gpm) <u>AC</u> (type power)			
(7) electric log <u>(yes or no)</u> <u>(organization running log)</u>			
(8) how well bottom plugged <u>orange</u> <u>peel</u>			
DRILLERS REMARKS:			


CODED

RECEIVED
DEC 16 1985

Department of Natural Resources
Bureau of Land & Water Resources

If well telescopes please sketch and show depths.

GROUND LEVEL

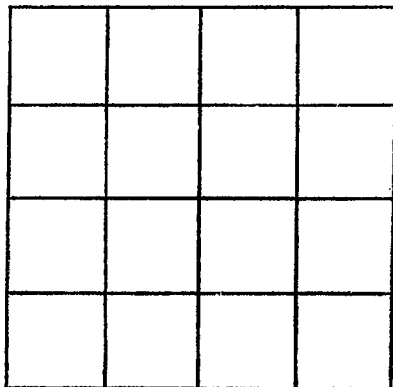

SECTION _____

Please indicate well location X.

ADDITIONAL INFORMATION

If more than one screen, show locations of each on sketch.