

MISSISSIPPI DEPARTMENT OF NATURAL RESOURCES

Bureau of Land and Water Resources

Southport Mall

P.O. Box 10631

Jackson, Mississippi 39209

WATER WELL DRILLERS LOG

CODED

Marion
9039
11-25-85

11-25 1985 date well completed Tom Griffith Waterwells firm name Marion county well located

LANDOWNER: Boss Enterprises
Two Lakesway Center - Suite 190
P.O. Box 6970
Metairie, LA 70009-6970
(mailing address)

description of formations encountered	from	to
Logs	1	5'
Sand	5	10
clay	10	15
gravel	15	60
fg gravel	60	120

WELL LOCATION:
sec. 32 T 1 (N) R 14 (E)
2 miles S of Sandyhook
(distance) (direction) (nearest town)

WELL PURPOSE: oil location
(home, irrigation, municipal, industrial)

- WELL COMPLETION DATA:
- (1) diameter (inches) 3"
 - (2) total depth (feet) 120'
 - (3) static water level (feet) 10' below above top of ground.
 - (4) casing PVC, 100',
(material) (depth)
NA if telescope see back.
(size)
 - (5) screen 20', 100'
(length) (depth to top)
3" PVC
(size) (material)
 - (6) pump air 80
(HP) (yield gpm)
direct
(type power)
 - (7) electric log no
(yes or no)
n/a
(organization running log)
 - (8) how well bottom plugged welded

RECEIVED


MAR 17 1986

Department of Natural Resources
Bureau of Land & Water Resources

DRILLERS REMARKS:

If well telescopes please sketch and show depths.

GROUND LEVEL

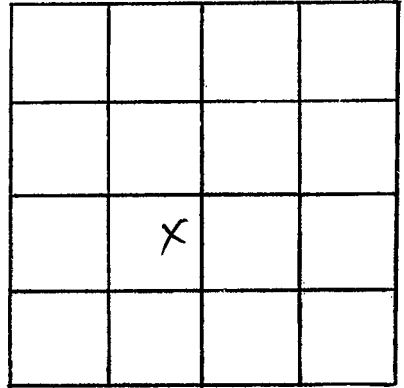

SECTION 32

Please indicate well location X.

ADDITIONAL INFORMATION

If more than one screen,
show locations of each on sketch.