

MARION  
Q 40

MISSISSIPPI DEPARTMENT OF NATURAL RESOURCES  
 Bureau of Land and Water Resources  
 Southport Mall  
 P.O. Box 10631  
 Jackson, Mississippi 39209  
**WATER WELL DRILLERS LOG**

1/22/85 19 Tom Griffith Well Service Marion, Me  
 date well completed firm name county well located

LANDOWNER: Bass Enterprises  
P.O. Box 6970  
METARIE, La 7009-6970  
 (mailing address)

description of formations encountered	from	to
Loqs	1'	5'
SAND	5'	10'
CLAY	10'	15'
Gravel	15'	60'
Pa - Gravel	60'	120'

WELL LOCATION:  
 sec. 32 T. 1 (N) R. 14 (E)  
 S W  
3 miles NE of Angie, La  
 (distance) (direction) (nearest town)

WELL PURPOSE: irrigation  
 (home, irrigation, municipal, industrial)


- WELL COMPLETION DATA:
- (1) diameter (inches) 3"
  - (2) total depth (feet) 120'
  - (3) static water level (feet) 5' <sup>below</sup> above top of ground.
  - (4) casing PVC, 80'  
 (material) (depth)  
N/A if telescope see back.  
 (size)
  - (5) screen 40', 80'  
 (length) (depth to top)  
3", PVC  
 (size) (material)
  - (6) pump 5, 90  
 (HP) (yield gpm)  
Electric  
 (type power)
  - (7) electric log No  
 (yes or no)  
N/A  
 (organization running log)
  - (8) how well bottom plugged BWV

DRILLERS REMARKS:

RECEIVED  
 JUL 14 1985  
 MISSISSIPPI DEPARTMENT OF NATURAL RESOURCES  
 BUREAU OF LAND AND WATER RESOURCES

If well telescopes please sketch and show depths.

GROUND LEVEL

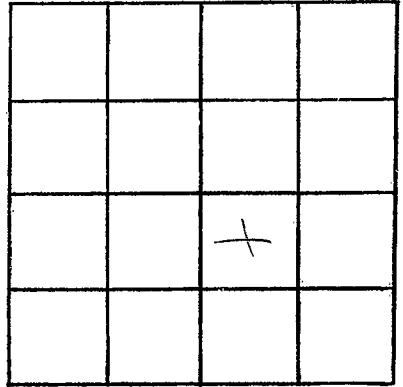

SECTION \_\_\_\_\_

Please indicate well location X.

ADDITIONAL INFORMATION

If more than one screen,  
show locations of each on sketch.