

# State Well Report

Part 1

Mississippi Department of Environmental Quality  
Office of Land and Water Resources  
P.O. Box 10631  
Jackson, MS 39289-0631  
(601)961-5210  
(601)354-6938 (fax)

County: Marion  
Permit #: \_\_\_\_\_  
Driller: J. C. Sumrall  
Date drilling completed: 11/14/05

For Office Use Only:  
Aquifer: \_\_\_\_\_  
Well #: Q-152  
L. S. Elevation: \_\_\_\_\_  
E-log #: \_\_\_\_\_

State Law requires that this report be prepared by the driller in detail and filed with the Department within 30 days of completion of drilling of the well.

Well Owner Information	Well Location
Owner Name: <u>Hershel Kennedy</u>	Latitude: <u>31° 04' 31"</u> Longitude: <u>89° 49' 01"</u>
Mailing Address: <u>31 ST. PAUL RD</u> <u>SANDY HOOK, MS</u>	Method of Lat/Long (circle one): Conventional Survey, USGS quad, Hand-held GPS, Survey-grade GPS
City _____ State _____ Zip Code _____	<u>SW 1/4 SW 1/4 Sec 16 Twn 1W Rng 14E</u>
Telephone No. <u>504 986-2297</u>	Distance _____ Direction <u>5</u> Nearest Town _____ <u>3</u> Miles <u>N</u> of <u>Sandy Hook MS</u>

**Well Data**

Purpose of Well (circle one) Home Industrial Public Supply Irrigation Fish Culture Other: \_\_\_\_\_

Date well drilling started: 11/14/05 Date well drilling completed: 11/14/05

If flowing, method of flow regulation: Valve \_\_\_\_\_ Other (describe) \_\_\_\_\_

Static Water Level: 17 feet above or below (circle one) land surface Date measured: 11/14/05

Method of Measurement (circle one) steel tape electric tape air line other: \_\_\_\_\_

Hole depth: 65 Well depth: 65 Well grouted to a depth of 10 feet

Type of grout (circle one): Cement Bentonite Mix

Casing length: 55 feet Casing diameter: 4 inches Type of casing: PVC

Screen length: 10 feet Screen diameter: 4 inches Type of screen: PVC

Screen slot size: 1010 inches Setting depth: From 55 feet to 65 feet

Type of completion (circle all applicable): Gravel packed Underreamed Telescoped Open hole Natural Development

Other (describe): \_\_\_\_\_


Top of lap pipe or reduction in casing: \_\_\_\_\_ feet. If telescoped or more than one screen, describe on back of page

Logs run (circle all applicable): No log run Electric Gamma Ray Density Sonic Neutron Other: \_\_\_\_\_

Name of organization running log(s): \_\_\_\_\_

I certify that the well was drilled, constructed, and completed in accordance with all applicable requirements of the Mississippi Department of Environmental Quality and/or the Mississippi Department of Health regulations and state laws.

Jordan Well Ser 0-508  
Print Name of Water Well Contractor and License No.

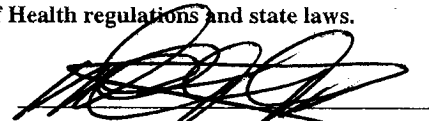  
Signature of Water Well Contractor

RECEIVED

DEC 02 2005

BY: OLWR

If well telescopes please sketch below and show depths.

Q-152


Ground Level

--

Description of Formations Encountered	From	To
Top Soil	0	1
Sandy Clay	1	15
Sand	15	65

If more than one screen, show location of each on sketch

Sketch the property layout and include the following: 1) the well location; 2) any permanent structures on the property that may aid in locating the well; 3) any roads, power lines, or other items that may aid in locating the property and the well; 4) indicate direction.

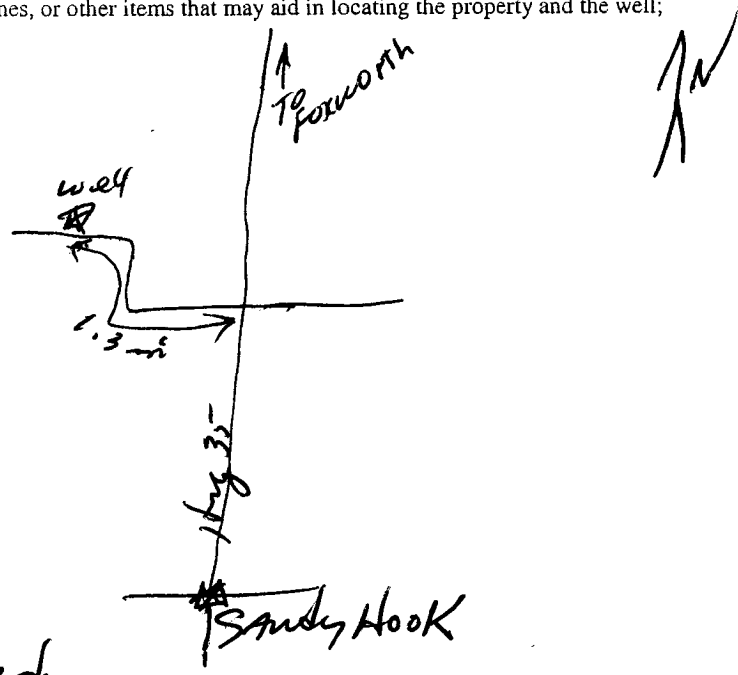

Landowner Name: Hershel Kennedy

Signature of Water Well Contractor

RECEIVED  
DEC 02 2005  
BY: OLWR

# STATE WELL REPORT

## Part 2

**Pump Installer's Completion Report**  
 Mississippi Department of Environmental Quality  
 Office of Land and Water Resources  
 P.O. Box 10631  
 Jackson, MS 39289-0631  
 (601)961-5210  
 (601)354-6938 (fax)

County: Marion  
 Permit #: \_\_\_\_\_  
 Driller: J.C. Scumvall  
 Date completed: 11/14/05

**For Office Use Only:**

Aquifer: \_\_\_\_\_  
 Well #: Q-152  
 Elevation: \_\_\_\_\_

This report should be prepared by the pump installer in detail and filed with the Department within 30 days of the installation of pump.

Well Owner Information	Well Location
Owner Name: <u>Hershel Kennedy</u>	Latitude: _____ Longitude: _____
Mailing Address: <u>31 St. Paul Rd</u> <u>Sandy Hook, MS</u>	Method of Lat/Long (circle one): Conventional Survey, USGS quad, Hand-held GPS, Survey-grade GPS
City State Zip Code	_____ 1/4 _____ 1/4 Sec <u>6</u> Twn <u>1</u> Rng <u>14</u>
Telephone No. (_____) _____	Distance Direction Nearest Town <u>3</u> Miles <u>N</u> of <u>Sandy Hook, MS.</u>

Pump Type Circle one	Power Type Circle one
Air Lift Jet <input type="radio"/> <u>Submersible</u>	Diesel Engine Gasoline Engine Natural Gas
Bucket Piston <input type="radio"/> Turbine <input type="radio"/>	<u>Electric Motor</u> Hand <input type="radio"/> Tractor PTO <input type="radio"/>
Centrifugal Rotary <input type="radio"/> Flowing Well <input type="radio"/>	Windmill Other (specify): _____
Other (specify): _____	Horse Power Rating of Motor: <u>1/2</u>
Date Pump Installed: <u>11/14/05</u>	Setting Depth: <u>55</u> feet
Rated Pump Capacity: <u>10</u> Gallons Per Minute	Number of Stages: <u>8</u>

Pump Test Data	Method of Measuring Water Level Circle one
Date Well Tested: <u>11/14/05</u>	Air Line Electric Measuring Line <u>Steel Tape</u>
Static Water Level (A): <u>17</u> Feet Below Land Surface	Other (specify): _____
Pumping Water Level (B): _____ Feet Below Land Surface	For flowing well, measured shut in head: _____ feet
Drawdown [(B) - (A)]: _____ Feet Below Land Surface	Well yielded <u>10</u> GPM with a drawdown of _____ feet after <u>4</u> hours of pumping
Test Pumping Rate: <u>10</u> Gallons Per Minute	
Duration of Pump Test (minimum 4 hours): <u>4</u> hours	

I HEREBY CERTIFY that the above statements are true to the best of my knowledge.

Jordan Well Ser. 0-508 \_\_\_\_\_  
 Print Name of Pump Installer and License No. (if applicable) Signature of Pump Installer

**RECEIVED**  
 DEC 02 2005  
 BY: OLWR