

MARION
 2000
 3/1/77

MISSISSIPPI
 BOARD OF WATER COMMISSIONERS
 416 North State Street
 Jackson, Mississippi 39201

WATER WELL DRILLERS LOG

13V
 13-1-5 1977 Hollinger's Marion
 date well completed firm name county well located

LANDOWNER: Thomas Stone description of formations encountered from to
 RT 5 Box 5119
 Columbia, Miss. 39429
 (mailing address) CHALK CLAY 0 10
 SAND GRAVEL 10 80

WELL LOCATION: 18 W
 sec. 12 T 1 N R 13 E
 4 miles S of SARINA
 (distance) (direction) (nearest town)

WELL PURPOSE: Home
 (home, irrigation, municipal, industrial)

WELL COMPLETION DATA:
 (1) diameter (inches) 2"
 (2) total depth (feet) 80
 (3) static water level (feet) 4 below top of ground.
 (4) casing PVC (material), (depth),
 (size) If telescope see back.
 (5) screen 5 75 (length), (depth to top)
 2" PVC (size), (material)
 (6) pump 1/2 8 (HP), (yield gpm)
 elect (type power)
 (7) electric log (yes or no)
 (organization running log)

(8) how well bottom plugged sand shanks


DRILLERS REMARKS: good

RECEIVED
 MAR - 7 1977

MISSISSIPPI BOARD OF WATER COMMISSIONERS

If well telescopes please sketch and show depths.

GROUND LEVEL

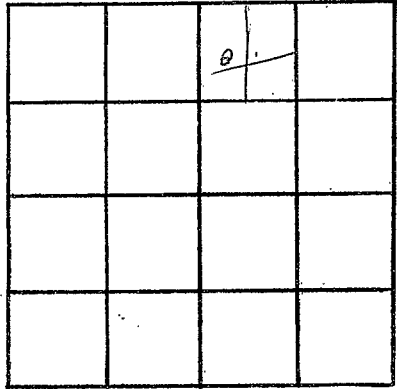

SECTION 12

Please indicate well location X.

ADDITIONAL INFORMATION

If more than one screen, show locations of each on sketch.