

Marion
 Q 2001
 3/9/77

MISSISSIPPI
 BOARD OF WATER COMMISSIONERS
 416 North State Street
 13V Jackson, Mississippi 39201

WATER WELL DRILLERS LOG

3/9 date well completed 1977 Hollinger Water Well firm name Marion county well located

13E in Wellhall Co.

LANDOWNER: Althea Anthony

description of formations encountered from to

RT 5 Box 191

Columbia, Miss 39429
 (mailing address)

CLAY	0	25
SAND GRAVEL	25	50
GRAVEL	50	87

WELL LOCATION: 18
 sec. 12 T 1(N) S R 13 E
 4 miles S of SPRING COLEMAN
 (distance) (direction) (nearest town)

WELL PURPOSE: Home
 (home, irrigation, municipal, industrial)

- WELL COMPLETION DATA:
- (1) diameter (inches) 2"
 - (2) total depth (feet) 87
 - (3) static water level (feet) 40 below top of ground. above
 - (4) casing PVC (material) (depth) _____
 (size) If telescope see back.
 - (5) screen 5 (length) 82 (depth to top)
2" (size) PVC (material)
 - (6) pump 1/2 (HP) 8 (yield gpm)
elect. (type power)
 - (7) electric log _____ (yes or no)
 (organization running log) _____
 - (8) how well bottom plugged sand & shank


DRILLERS REMARKS: good well

RECEIVED
 APR 26 1977

MISS. BD. OF WATER COMMISSIONERS

If well telescopes please sketch and show depths.

GROUND LEVEL

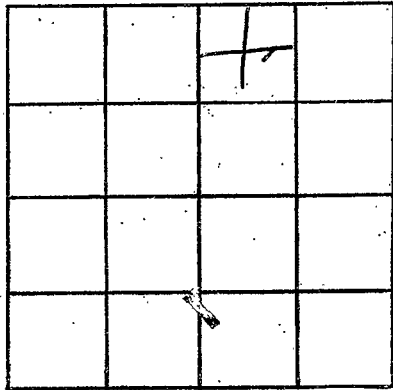

SECTION 12

Please indicate well location X.

ADDITIONAL INFORMATION

If more than one screen,
show locations of each on sketch.