

Marion
Q 2002
5/19/77

MISSISSIPPI
BOARD OF WATER COMMISSIONERS
416 North State Street
Jackson, Mississippi 39201

WATER WELL DRILLERS LOG

5/19 19 77 Hollinger Plumb. Marion
date well completed firm name county well located

LANDOWNER: Ruby Martan
Rt 1 Box 267
Sandy Hook, Miss
(mailing address)

description of formations encountered	from	to
CHALK SAND, pea gravel	0	10
	10	50

WELL LOCATION:
sec. 18 T. 1 (N) R. 14 E
2 miles NW of Sandy Hook
(distance) (direction) (nearest town)

WELL PURPOSE: Home
(home, irrigation, municipal, industrial)

WELL COMPLETION DATA:

(1) diameter (inches) 2"
(2) total depth (feet) 50
(3) static water level (feet) 6 below above top of ground.
(4) casing PVC, 45 (material) (depth) (size) if telescope see back.
(5) screen 5, 45 (length) (depth to top) 2" PVC (size) (material)
(6) pump 1/3 (HP) 7 (yield gpm) elect (type power)
(7) electric log (yes or no)
(organization running log)


(8) how well bottom plugged sand SPARK

DRILLERS REMARKS: good well

RECEIVED
JUN 15 1977
MISS. BD. OF WATER COMMISSIONERS

If well telescopes please sketch and show depths.

GROUND LEVEL

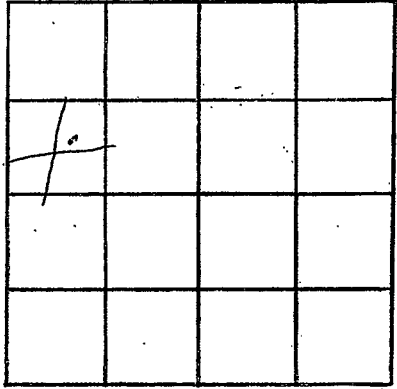

SECTION 18

Please indicate well location X.

ADDITIONAL INFORMATION

If more than one screen, show locations of each on sketch.