

MARION
 Q 2003
 1/17/78

MISSISSIPPI
 BOARD OF WATER COMMISSIONERS
 416 North State Street
 Jackson, Mississippi 39201

WATER WELL DRILLERS LOG

1/17 date well completed 1978 Hollinsec's firm name Marion county well located

LANDOWNER: Thomas Donald
 RT 1
 Sandy Hook, MS
 (mailing address)

description of formations encountered	from	to
CHALK	0	20
sand, gravel	20	80


WELL LOCATION:
 sec. 8 T-10 N R-14 E
 At St. Paul.
 (distance) miles (direction) of (nearest town)

WELL PURPOSE: Home
 (home, irrigation, municipal, industrial)

- WELL COMPLETION DATA:
- (1) diameter (inches) 2
 - (2) total depth (feet) 80
 - (3) static water level (feet) 10 ^{below} above top of ground.
 - (4) casing PVC 20 (material) (depth)
 (size) If telescope see back.
 - (5) screen 5 95 (length) (depth to top)
 2 PVC (size) (material)
 - (6) pump 1/2 6 (HP) (yield gpm)
 elect (type power)
 - (7) electric log (yes or no)

(organization running log)
 (8) how well bottom plugged sand shales


DRILLERS REMARKS: Very good

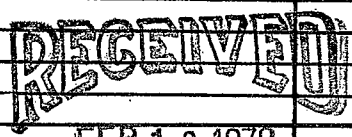

FEB 10 1978

If well telescopes please sketch and show depths.

GROUND LEVEL

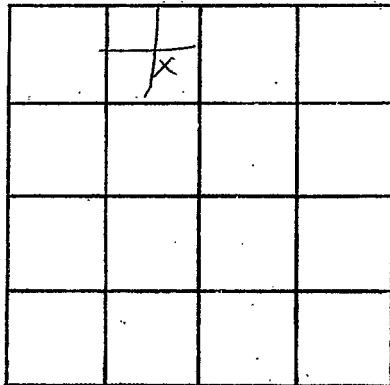

SECTION 8

Please indicate well location X.

ADDITIONAL INFORMATION

Lined area for additional information.

If more than one screen, show locations of each on sketch.