

MARION

Q 2004

3-29-78

MISSISSIPPI BOARD OF WATER COMMISSIONERS  
416 North State Street  
Jackson, Mississippi 39201

WATER WELL DRILLERS LOG

~~March 29~~ 1978

Jim Giffitt Well

Marion

date well completed

well name Service

county well located

LANDOWNER:

Mrs Wilmer Mc Murray

Rt. 1 Sandy Hook Miss.  
(mailing address)

description of formations encountered

from

to

top soil	0	2
clay	2	60
sand & gravel	60	100

WELL LOCATION:

sec. 5 T 1 N R 14 E  
15 miles S of Clanton  
(distance) (direction) (nearest town)

WELL PURPOSE: Home  
(home, irrigation, municipal, industrial)

WELL COMPLETION DATA:

- (1) diameter (inches) 4"
- (2) total depth (feet) 100 ft
- (3) static water level (feet) 110 ft below top of ground.
- (4) casing plastic 80 ft  
(material) (depth)  
4" (size) if telescope see back.
- (5) screen 20 ft 80 ft  
(length) (depth to top)  
4" (size) plastic (material)
- (6) pump 1/2 hp  
(HP) (yield gpm)  
elec (type power)
- (7) electric log no  
(yes or no)  
ma (organization running log)

(8) how well bottom plugged  
B. W. Value

DRILLERS REMARKS:


RECEIVED

APR 27 1978

MISS. BD. OF WATER COMMI

If well telescopes please sketch and show depths.

GROUND LEVEL

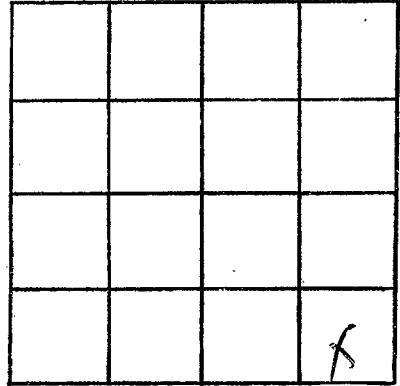

SECTION 5

Please indicate well location X.

ADDITIONAL INFORMATION

If more than one screen,  
show locations of each on sketch.