

MARION
Q
2005

MISSISSIPPI
BOARD OF WATER COMMISSIONERS
416 North State Street
Jackson, Mississippi 39201

WATER WELL DRILLERS LOG

TOM GRIFFITH
PLUMBING & WELL SERVICE, INC.

320 WYSON AVE.
COLUMBIA, MS 39429

Marion
county well located

4-27-78
date well completed

LANDOWNER:

Gary Stringer
Pt. 1 Sandy Hook, Ms.
(mailing address)

description of formations encountered

*Top Soil
1" clay
sand*

from to

0 3
3 20
20 65

WELL LOCATION:

sec. 6 T 10 N R. 14 E
10 miles S of Columbia
(distance) (direction) (nearest town)

WELL PURPOSE:

Home
(home, irrigation, municipal, industrial)

WELL COMPLETION DATA:

- (1) diameter (inches) 2"
- (2) total depth (feet) 65 ft
- (3) static water level (feet) 60 ft below top of ground.
- (4) casing Plastic 55 ft
(material) (depth)
2"
(size) If telescope see back.
- (5) screen 10 ft 55 ft
(length) (depth to top)
2" plastic
(size) (material)
- (6) pump 1/2 HP
(HP) (yield gpm)
Elec.
(type power)
- (7) electric log No.
(yes or no)
N/A
(organization running log)
- (8) how well bottom plugged 10" w. valve

DRILLERS REMARKS:


RECEIVED

MAY 24 1978

MISS. BD. OF WATER COMMISSIONERS

If well telescopes please sketch and show depths.

GROUND LEVEL

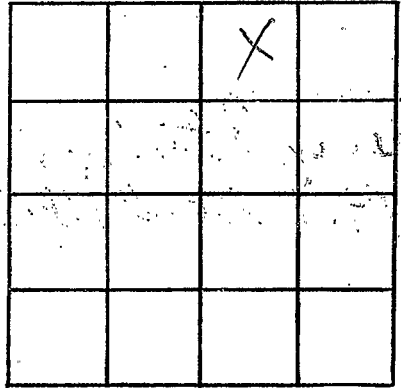

SECTION 6

Please indicate well location X.

ADDITIONAL INFORMATION

If more than one screen,
show locations of each on sketch.