

MARION  
 Q  
 6-16-78  
 2006

MISSISSIPPI  
 BOARD OF WATER COMMISSIONERS  
 416 North State Street  
 Jackson, Mississippi 39201

WATER WELL DRILLERS LOG

6/16 19 78 Hollinger Well Co. MARION  
 date well completed firm name county well located

LANDOWNER: Ben McKensie	description of formations encountered		from	to
RT1				
Sandy Hook, Ms (mailing address)	CLAY SAND SAND, gravel		0 20	80 147

WELL LOCATION:  
 sec. 7 T. 10 N. R. 7 E. 14 E  
 S W  
 5 miles NW of Sandy Hook  
 (distance) (direction) (nearest town)

WELL PURPOSE: HOME  
 (home, irrigation, municipal, industrial)

- WELL COMPLETION DATA:
- (1) diameter (inches) 2
  - (2) total depth (feet) 147
  - (3) static water level (feet) 100 <sup>below</sup> <sub>above</sub> top of ground.
  - (4) casing PVC, 142  
 (material) (depth)  
 (size) if telescope see back.
  - (5) screen 5, 142  
 (length) (depth to top)  
2", PVC  
 (size) (material)
  - (6) pump 1 1/2, 8  
 (HP) (yield gpm)  
elect  
 (type power)
  - (7) electric log (yes or no) \_\_\_\_\_
  - (organization running log) \_\_\_\_\_
  - (8) how well bottom plugged sand shark cased well


RECEIVED  
 AUG 14 1978

DRILLERS REMARKS: very good

MISS. BD. OF WATER COMMISSIONERS

If well telescopes please sketch and show depths.

GROUND LEVEL

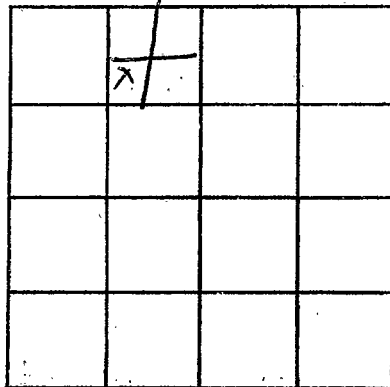

SECTION 7

Please indicate well location X.

ADDITIONAL INFORMATION

If more than one screen,  
show locations of each on sketch.