

MARION  
 Q  
 6-26-78  
 2007

MISSISSIPPI  
 BOARD OF WATER COMMISSIONERS  
 416 North State Street  
 Jackson, Mississippi 39201

WATER WELL DRILLERS LOG

6/26 1978 Hollinsec Well MARION  
 date well completed firm name county well located

LANDOWNER: Daniel Preston  
 Rt 5 Box 135  
 Columbia MS  
 (mailing address)

description of formations encountered	from	to
Sand, chalk	0	20
per gravel	26	68

WELL LOCATION:  
 sec. 7 T 10 N R 14 E  
 5 miles S of Springs  
 (distance) (direction) (nearest town)

WELL PURPOSE: Home  
 (home, irrigation, municipal, industrial)

WELL COMPLETION DATA:

(1) diameter (inches) 2"  
 (2) total depth (feet) 68  
 (3) static water level (feet) 12 <sup>below</sup> above top of ground.  
 (4) casing PVC, 68 (material) (depth)  
 (size) if telescope see back.  
 (5) screen 5, 63 (length) (depth to top)  
 2" PVC (size) (material)  
 (6) pump 1/2, 7 (HP) (yield gpm)  
 elect (type power)  
 (7) electric log (yes or no)  
 (organization running log)

(8) how well bottom plugged sand  
 SHARK


DRILLERS REMARKS: Very good

RECEIVED  
 AUG 14 1978

MISS. BD. OF WATER COMMISSIONERS

If well telescopes please sketch and show depths.

GROUND LEVEL

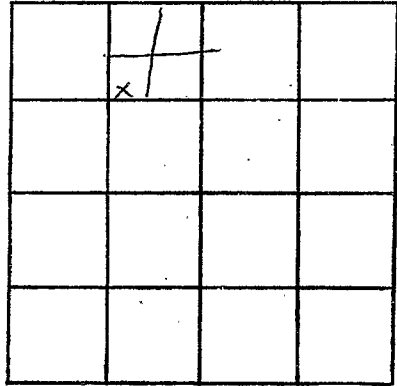

SECTION 7

Please indicate well location X.

ADDITIONAL INFORMATION

A series of horizontal lines for writing additional information.

If more than one screen, show locations of each on sketch.