

MARION  
 0 2008  
 3-21-79

MISSISSIPPI  
 BOARD OF WATER COMMISSIONERS  
 416 North State Street  
 Jackson, Mississippi 39201

WATER WELL DRILLERS LOG

March 21 1979 date well completed  
 TOM GRIFFITH PLUMBING & WELL SERVICE, INC. firm name  
 Monahan county well located

LANDOWNER:  
 Mrs. Katherine Laurent  
 Rt. 3, Box 91A - Joplin, Mo.  
 (mailing address) Miss.  
 sec. 8 T 1 S R. 14 E  
 2 miles N Smithville  
 (distance) (direction) (nearest town)

description of formations encountered	from	to
Topsoil	0	2
Sand	0	8
Gravel	8	14
Sand	14	31
Chalk	31	46
Sand	46	65

WELL PURPOSE:  
 (home, irrigation, municipal, industrial)  
 Home

WELL COMPLETION DATA:

(1) diameter (inches) 2"

(2) total depth (feet) 65 ft

(3) static water level (feet) 18 ft below top of ground.

(4) casing plastic 45 ft (material) (depth)  
 2" (size) if telescope see back.

(5) screen 20 ft - 45 ft (length) (depth to top)  
 2" (size) plastic (material)

(6) pump 1 HP 10 gals (HP) (yield gpm)  
 Elec- (type power)

(7) electric log no (yes or no)

(organization running log)  
 Back Wash Valve

(8) how well bottom plugged

DRILLERS REMARKS:


Miss. Board of Water Comm.

JUL 5 1979

RECEIVED

If well telescopes please sketch and show depths.

GROUND LEVEL

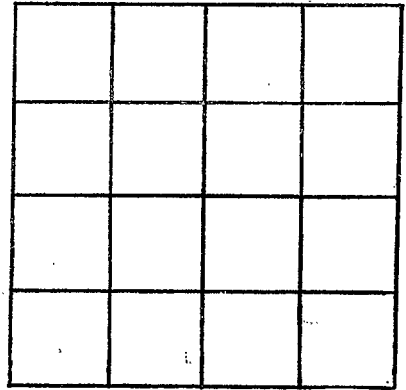

SECTION \_\_\_\_\_

Please indicate well location X.

ADDITIONAL INFORMATION

If more than one screen, show locations of each on sketch.