

MARION  
Q 2010  
7-23-80

MISSISSIPPI  
BOARD OF WATER COMMISSIONERS  
416 North State Street  
Jackson, Mississippi 39201

WATER WELL DRILLERS LOG

7-23 19 80 Hollinger Marion  
date well completed firm name county well located

LANDOWNER: Emos J. Parker

description of formations encountered	from	to
CHALK GRAVEL, SAND	0	20
	20	80

Spring Cottage  
(mailing address)

WELL LOCATION:

sec. 1 T-1(N) R-11E 1820  
1/2 miles S of Spring Cottage  
(distance) (direction) (nearest town)

WELL PURPOSE:  
(home, irrigation, municipal, industrial)

WELL COMPLETION DATA:

- (1) diameter (inches) 2
- (2) total depth (feet) 80
- (3) static water level (feet) 15 below above top of ground.
- (4) casing PVC 75 (material) (depth)
- (size) If telescope see back.
- (5) screen 5 75 (length) (depth to top)
- (size) PVC (material)
- (6) pump 1 12 (HP) (yield gpm)
- elect (type power)
- (7) electric log (yes or no)

(organization running log)

(8) how well bottom plugged SAND SHARK

DEPT. OF NATURAL RESOURCES  
BUREAU OF LAND & WATER RESOURCES


OCT 20 1980

DRILLERS REMARKS: Good Well

RECEIVED

If well telescopes please sketch and show depths.

GROUND LEVEL

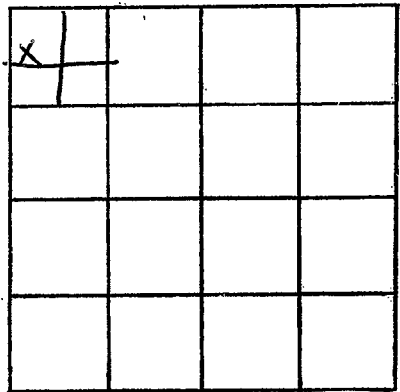

SECTION 1

Please indicate well location X.

ADDITIONAL INFORMATION

A series of horizontal lines for recording additional information.

If more than one screen, show locations of each on sketch.