

MARION  
 2014

MISSISSIPPI DEPARTMENT OF NATURAL RESOURCES  
 Bureau of Land and Water Resources  
 Southport Mall  
 P.O. Box 10631  
 Jackson, Mississippi 39209  
 WATER WELL DRILLERS LOG

Mar 19 1987 Fitzgerald Well Serv Marion  
 date well completed firm name county well located

LANDOWNER:	description of formations encountered	from	to
<u>Wilbert Lowell</u> <u>R.R. Sandhook, Ms.</u> (mailing address)			
WELL LOCATION: sec. <u>18</u> T <u>1</u> N R <u>14</u> E S W			
<u>6</u> miles (distance) of <u>direction</u> of <u>nearest town</u>			
WELL PURPOSE: <u>Home</u> (home, irrigation, municipal, industrial)			
WELL COMPLETION DATA:			
(1) diameter (inches) <u>4</u>			
(2) total depth (feet) <u>260</u>			
(3) static water level (feet) <u>140</u> below above top of ground.			
(4) casing <u>PVC</u> , <u>250</u> , (material) (depth) <u>4</u> (size) if telescope see back.			
(5) screen <u>10</u> , <u>250</u> (length) (depth to top) <u>4</u> , <u>PVC</u> (size) (material)			
(6) pump <u>1</u> , <u>12</u> (HP) (yield gpm) <u>elec</u> (type power)			
(7) electric log <u>no</u> (yes or no) <u>organization running log</u>			
(8) how well bottom plugged <u>sealed</u>			


RECEIVED  
 MAR 20 1987

Department of Natural Resources  
 Bureau of Land & Water Resources

DRILLERS REMARKS:

If well telescopes please sketch and show depths.

GROUND LEVEL

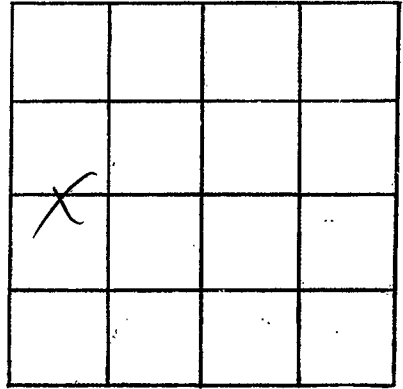

SECTION 18

Please indicate well location X.

ADDITIONAL INFORMATION

If more than one screen, show locations of each on sketch.