

**MISSISSIPPI DEPARTMENT OF NATURAL RESOURCES**  
**Bureau of Land and Water Resources**  
 Southport Mall  
 P.O. Box 10631  
 Jackson, Mississippi 39209  
**WATER WELL DRILLERS LOG**

MARION  
Q 2015

4-11 1988 Louis Batson Marion  
 date well completed firm name county well located

LANDOWNER: Jim McMurry  
Rt. 1, Box 254  
Sandy Hook, MS. 39478  
 (mailing address)

description of formations encountered  
Sand, gravel from 1 to 135

WELL LOCATION:  
 sec 6 T 1 N R 14 E  
8 miles S of Columbia  
 (distance) (direction) (nearest town)

WELL PURPOSE: home  
 (home, irrigation, municipal, industrial)

- WELL COMPLETION DATA:
- (1) diameter (inches) 4"
  - (2) total depth (feet) 135
  - (3) static water level (feet) 8 below above top of ground.
  - (4) casing 40 PVC, 135  
 (material) (depth)  
4 if telescope see back.  
 (size)
  - (5) screen 10, 125  
 (length) (depth to top)  
4, PVC  
 (size) (material)
  - (6) pump \_\_\_\_\_ (HP) \_\_\_\_\_ (yield gpm)  
 (type power)
  - (7) electric log \_\_\_\_\_ (yes or no)  
 (organization running log)
  - (8) how well bottom plugged \_\_\_\_\_

**RECEIVED**

MAY 09 1988

Department of Natural Resources  
 Bureau of Land & Water Resources

DRILLERS REMARKS:


If well telescopes please sketch and show depths.

GROUND LEVEL

-135

-10ft  
screen

If more than one screen,  
show locations of each on sketch.

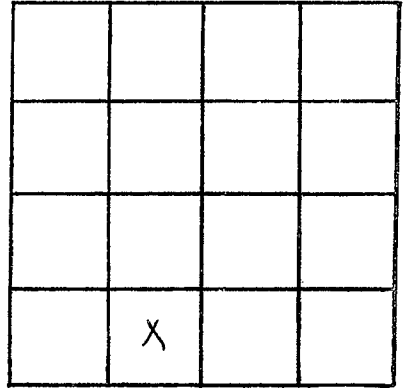

SECTION 6

Please indicate well location X.

ADDITIONAL INFORMATION

Lined area for additional information.